


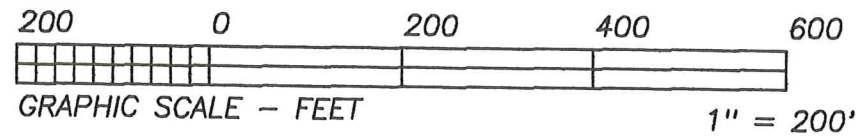


BEARINGS ESTABLISHED FROM PLAT 14/415 AND ARE TO DENOTE ANGULAR MEASUREMENT ONLY.



HEARTLAND SURVEYING, INC

Jim Shamp
5210 T.R. 257 MILLERSBURG, OH 44654
PH: 330-674-4698

SURVEY		MOUKEO AIR RALSTON		STATE		OHIO	
COUNTY	HOLMES	TWP.	KNOX	RNG.	15 W	TWP.	19 N
SOUTHEAST QUARTER OF SECTION 24				4/99 990434			

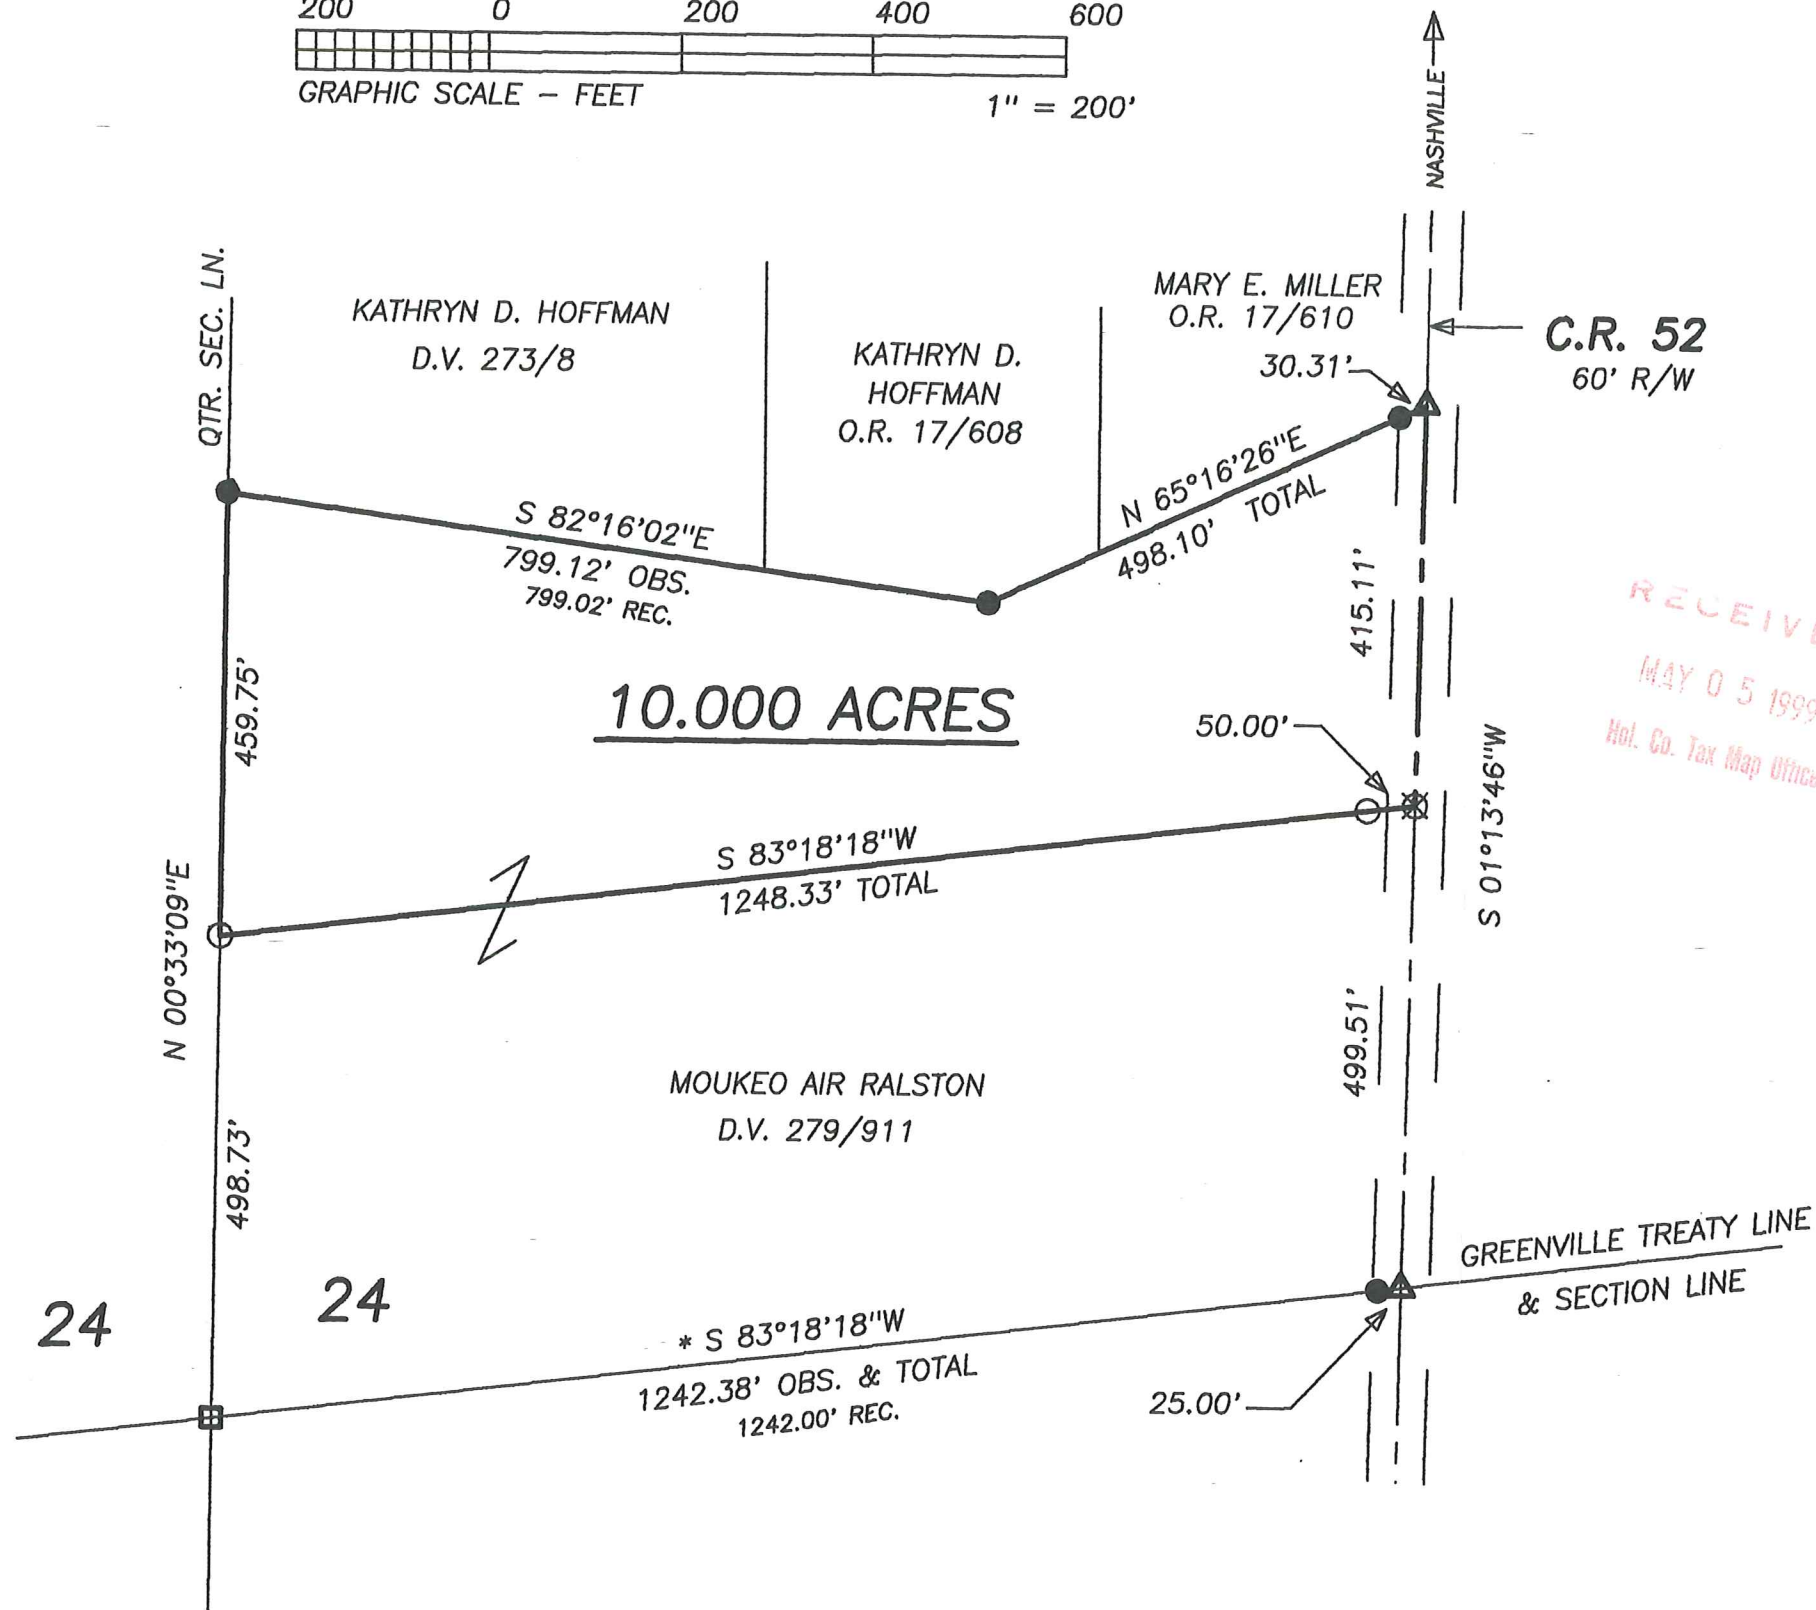

- LEGEND:
- = STONE FD.
 - = 5/8" RE-BAR FD. UNLESS NOTED
 - = POINT-OF-DEPARTURE
 - = 5/8" X 30" RE-BAR W/PLASTIC I.D. CAP SET
 - ⊗ = R/R SPIKE SET
 - △ = R/R SPIKE FD.

REFERENCE DOCUMENTS:
TAX MAPS
DEEDS AS SHOWN
SURVEY PLATS: 14/415

RECEIVED
MAY 05 1999
Hol. Co. Tax Map Office

MAP OFFICE COPY

I CERTIFY THIS PLAT & SURVEY TO BE CORRECT TO THE BEST OF MY KNOWLEDGE:

JIM SHAMP, REG. SUR. NO. S-6088 DATE

APRIL 26, 1999

