


REFERENCES

DEED VOL. 251 PAGE 582
 O.R. VOL. 226 PAGE 817
 PLAT VOL. 6 PAGE 157
 BEARINGS FROM O.R. VOL. 666 PAGE 165
 (ASHLAND COUNTY RECORDS)

KNOX TOWNSHIP
 S.W. QTR. SECTION 30
 T-19 N; R-15 W
 HOLMES COUNTY, OHIO

APR 10 '12 PM 1:03

SURVEYED FOR: JIM LANDOLL

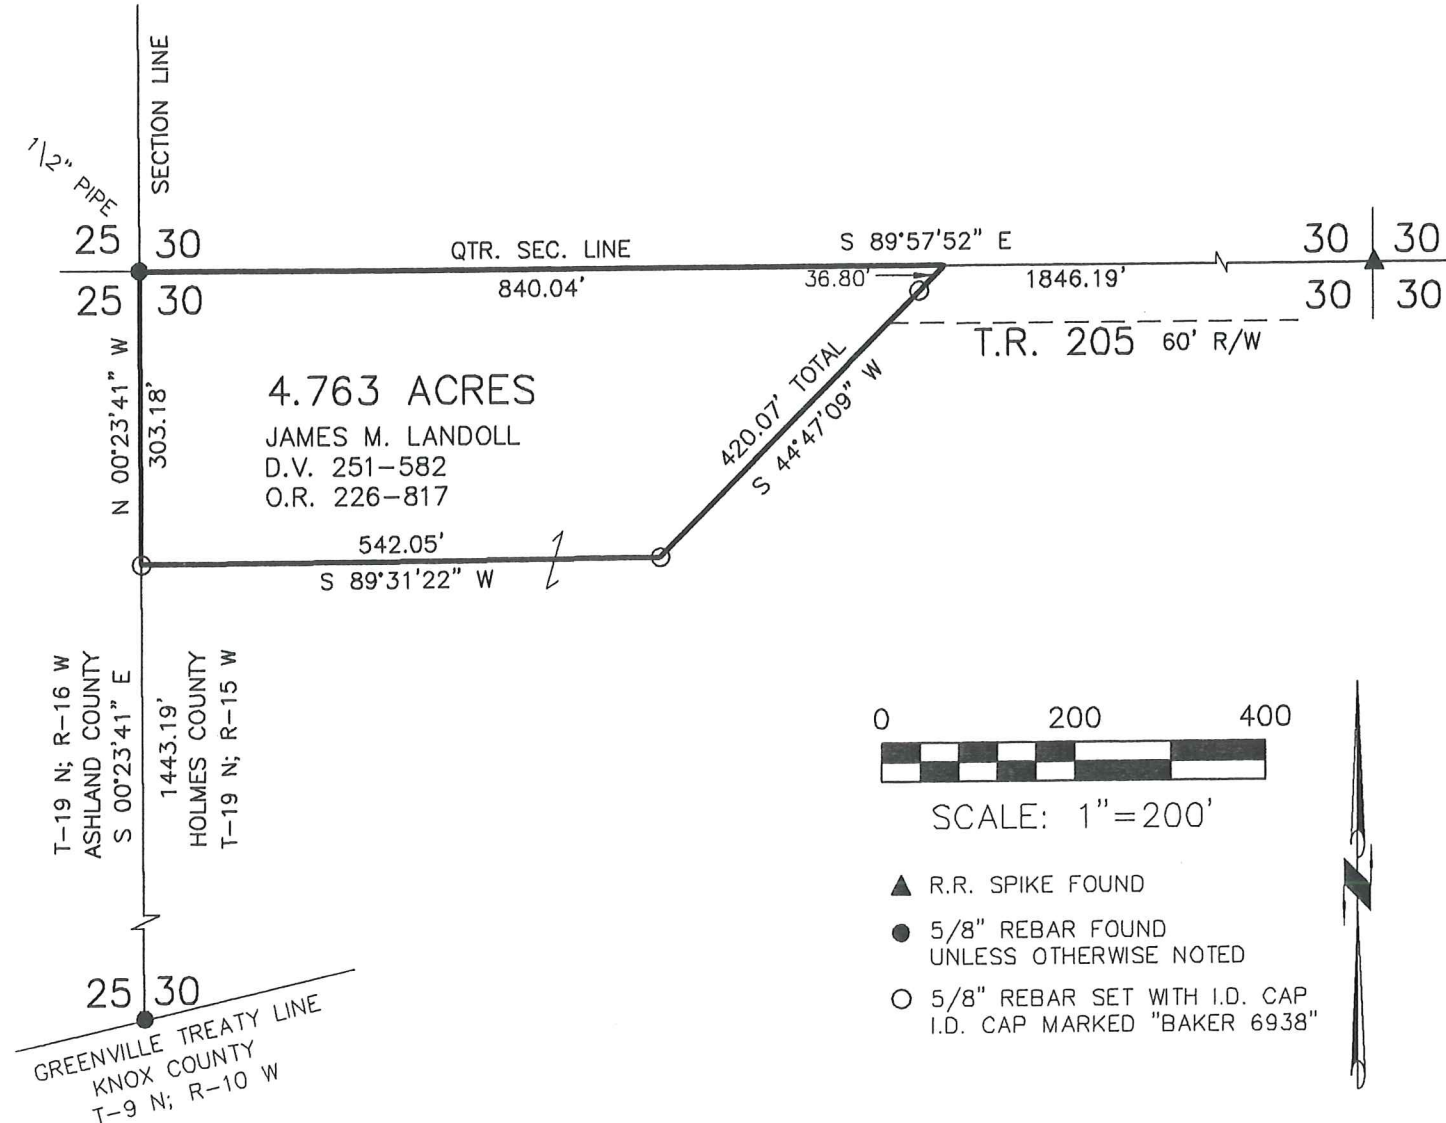

0 200 400



SCALE: 1" = 200'

- ▲ R.R. SPIKE FOUND
- 5/8" REBAR FOUND
UNLESS OTHERWISE NOTED
- 5/8" REBAR SET WITH I.D. CAP
I.D. CAP MARKED "BAKER 6938"



I CERTIFY THIS SURVEY TO BE CORRECT
 TO THE BEST OF MY KNOWLEDGE.

Donald C. Baker
 DONALD C. BAKER P.S. 6938
 DATE: MARCH 30, 2012
 FDB \CJG
 FILE NAME: WORK4\S-134-12\MLD



DONALD C. BAKER SURVEYING
 138 N. CLAY STREET
 MILLERSBURG, OHIO 44654
 PH. 330-674-4788
 FAX 330-674-6027