

PROPERTY LINE SURVEY

KNOX TOWNSHIP
1ST. QTR., LOT 10
T-9 N; R-9 W
HOLMES COUNTY, OHIO

REFERENCES

O.R. VOL. 25 PAGE 867
O.R. VOL. 181 PAGE 1697
O.R. VOL. 205 PAGE 749

PLAT VOL. 18 PAGE 553
PLAT VOL. 19 PAGE 481

BEARINGS FROM PLAT VOL. 19 PAGE 481


SURVEYED FOR: LEVI MAST

0 300 600




SCALE: 1"=300'

- STONE FOUND
- 5/8" REBAR FOUND UNLESS OTHERWISE NOTED
- 5/8" REBAR SET WITH I.D. CAP I.D. CAP MARKED "BAKER 6938"

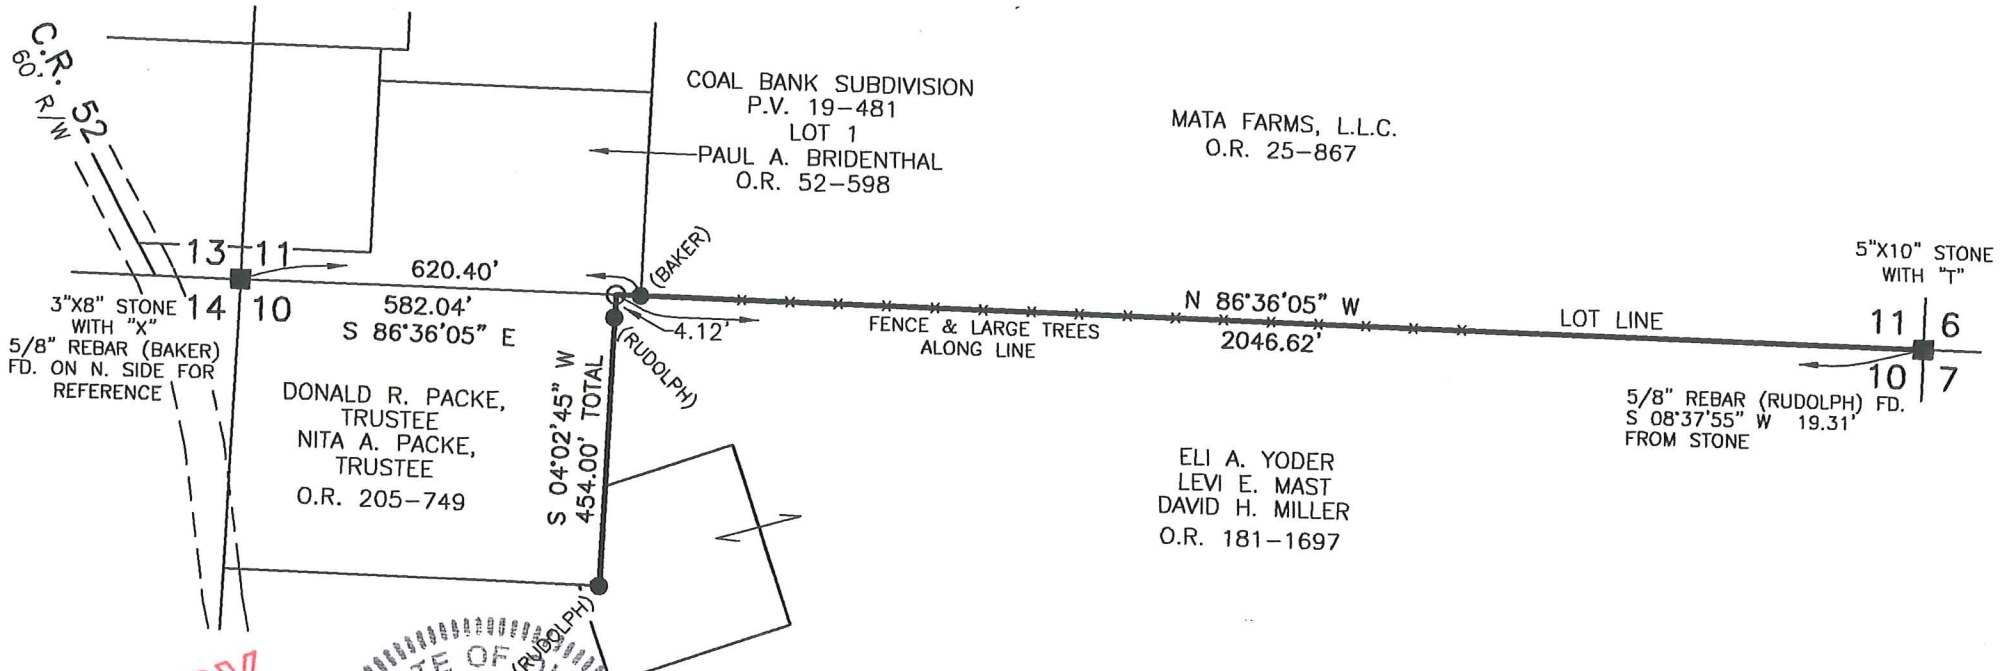

I CERTIFY THIS SURVEY TO BE CORRECT TO THE BEST OF MY KNOWLEDGE.

A.L.G.
AARON L. GERBER P.S. 8379
DATE: NOV. 18, 2010
ALG\CJG
FILE NAME: WORK3\S-332-10\ERZ

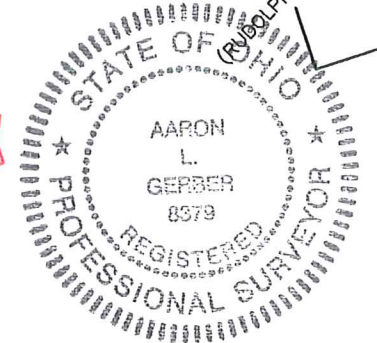

DONALD C. BAKER SURVEYING
138 N. CLAY STREET
MILLERSBURG, OHIO 44654
PH. 330-674-4788
FAX 330-674-6027