

SEP 6 '07 PM 12:37

RETRACEMENT SURVEY OF D.V. 158-516

KNOX TOWNSHIP
1ST. QTR., LOT 13
T-9 N; R-9 W
HOLMES COUNTY, OHIO

SURVEYED FOR: GLORIA SMETZER


REFERENCES

- DEED VOL. 158 PAGES 471, 513 & 516
- O.R. VOL. 81 PAGE 698
- PLAT VOL. 4 PAGES 96 & 98
- PLAT VOL. 7 PAGE 256
- PLAT VOL. 19 PAGE 329
- BEARINGS FROM PLAT VOL. 4 PAGE 96




SCALE: 1"=100'

- ▲ R.R. SPIKE FOUND
- 5/8" REBAR FOUND
UNLESS OTHERWISE NOTED
- 5/8" REBAR WITH I.D. CAP SET
I.D. CAP MARKED "BAKER 6938"

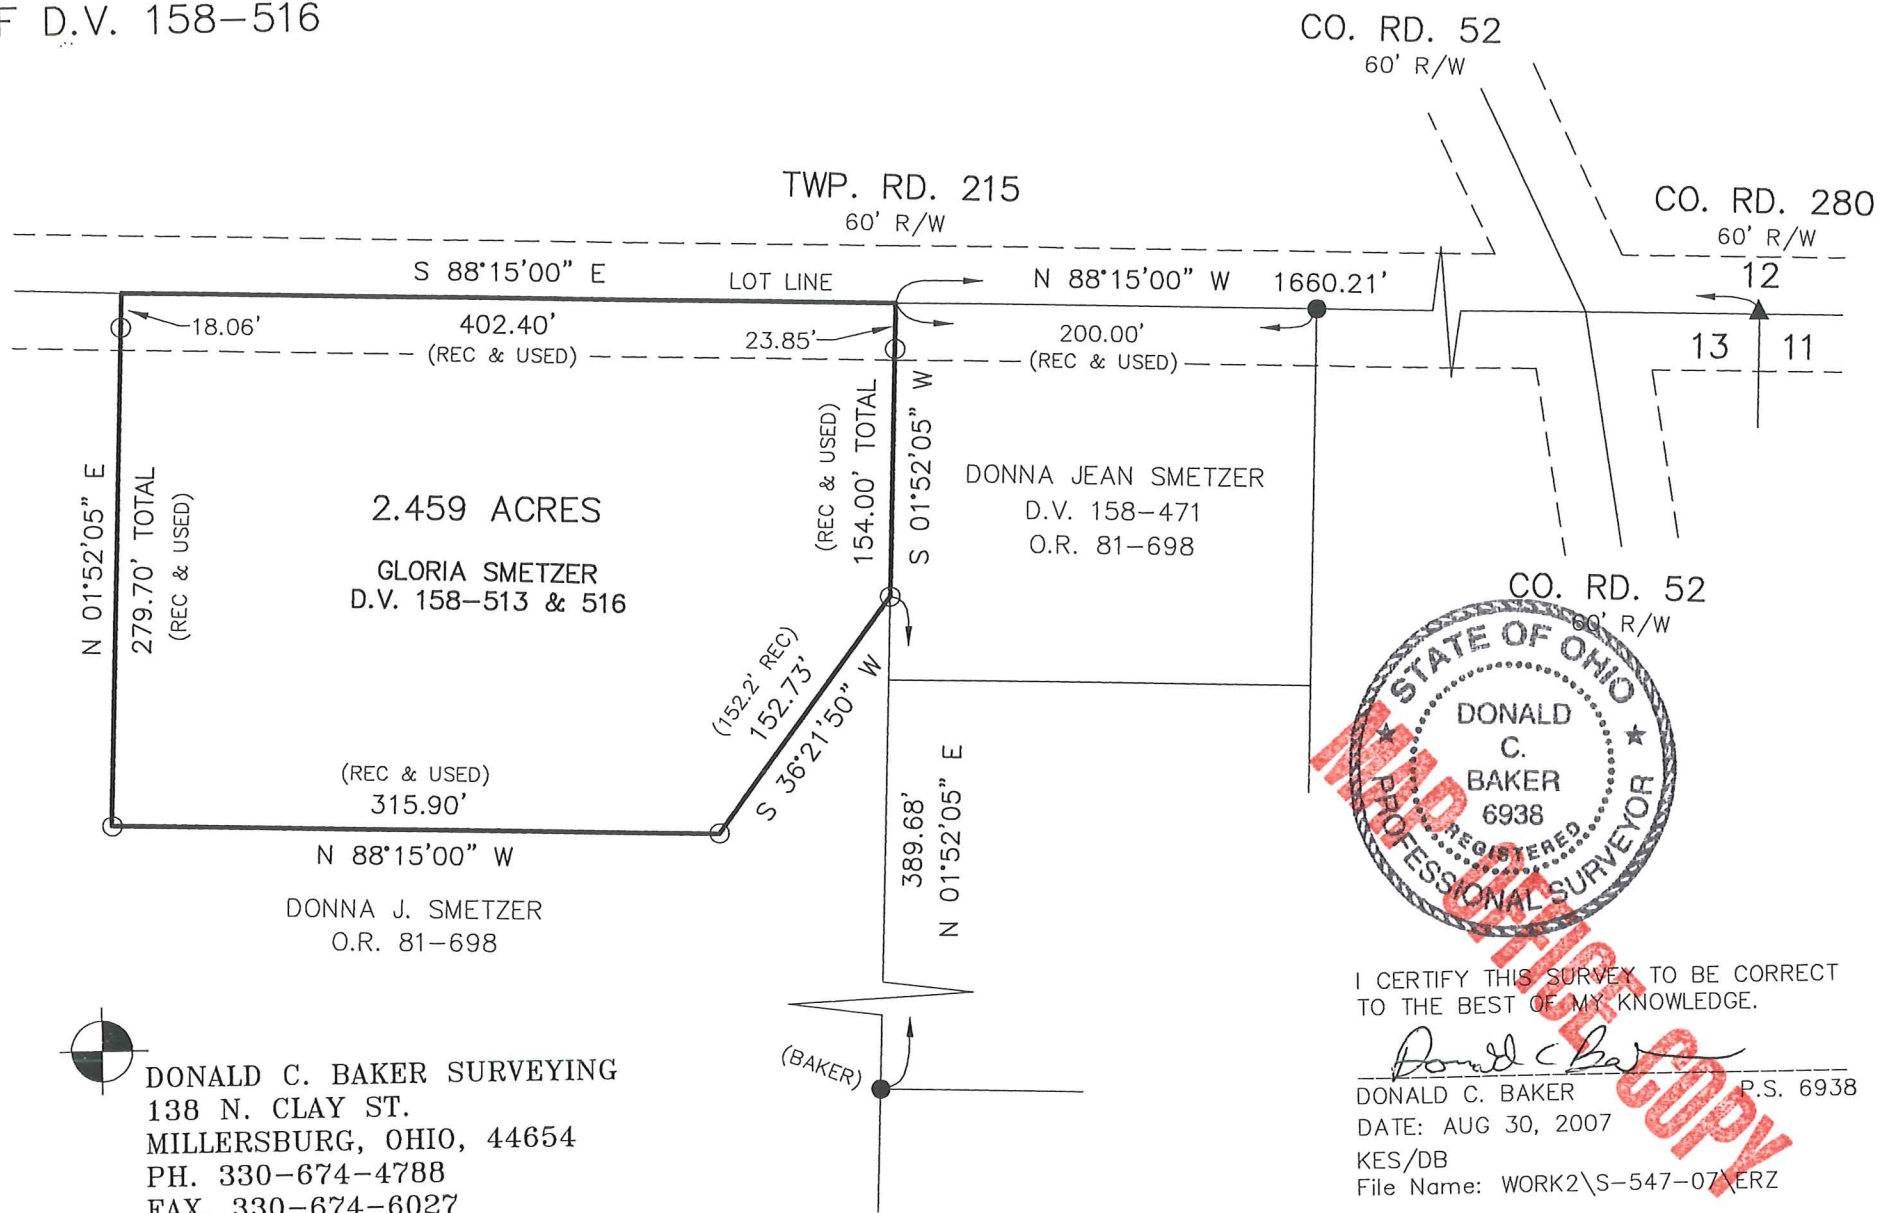

DONALD C. BAKER SURVEYING
138 N. CLAY ST.
MILLERSBURG, OHIO, 44654
PH. 330-674-4788
FAX. 330-674-6027

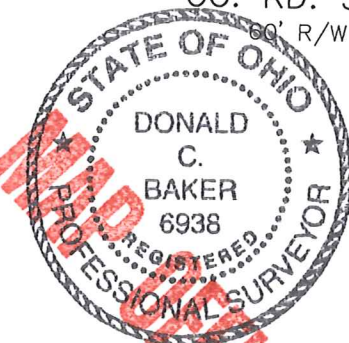

I CERTIFY THIS SURVEY TO BE CORRECT
TO THE BEST OF MY KNOWLEDGE.

Donald C. Baker
DONALD C. BAKER P.S. 6938
DATE: AUG 30, 2007
KES/DB
File Name: WORK2\S-547-07\ERZ