



SCALE: 1" = 100'

- STONE FOUND
- IRON PIN FOUND
- 5/8" RE BAR WITH I.D. CAP SET
I.D. CAP MARKED "BAKER 6938"




KNOX TOWNSHIP
1ST. QTR. LOT 15
T-9N; R-9W
HOLMES COUNTY, OHIO

REFERENCES:


DEED VOL. 234 PAGE 570
DEED VOL. 205 PAGE 747
DEED VOL. 173 PAGE 256
PLAT VOL. 10 PAGE 712

SURVEY OF PROPERTY LINE
BETWEEN 1ST. QTR. LOT 15
& 4TH. QTR. LOTS 29 & 30

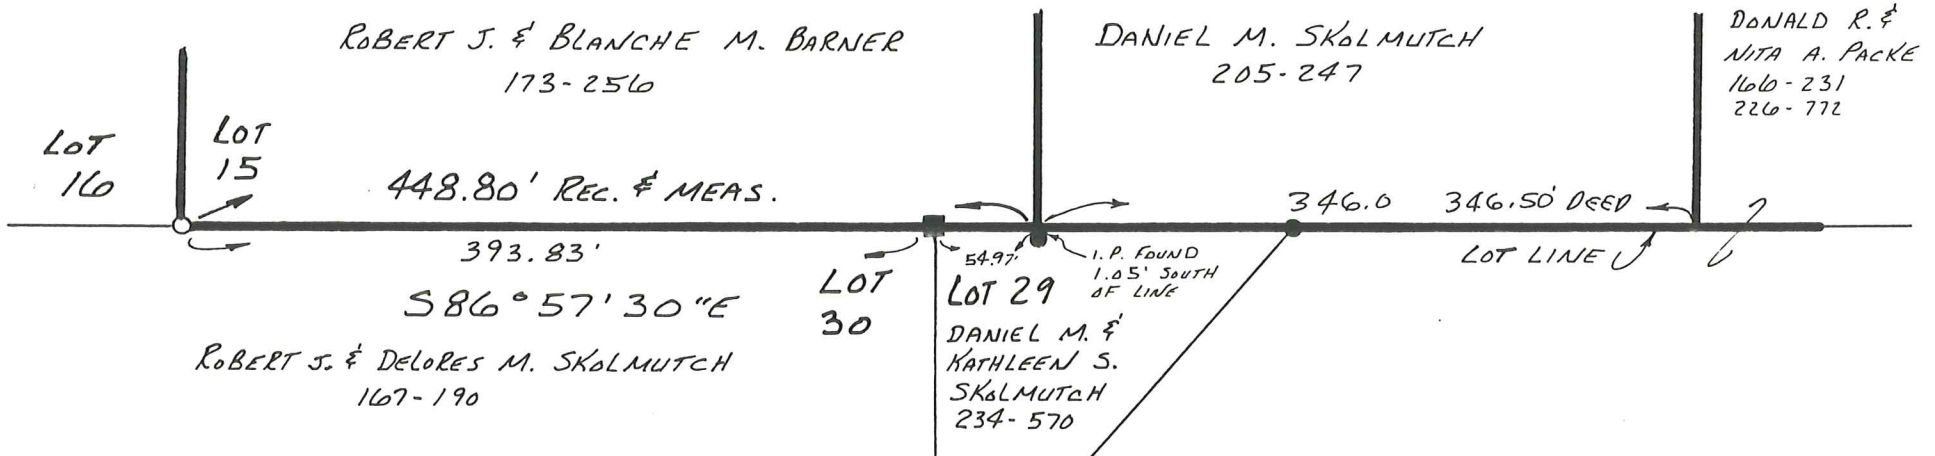

I CERTIFY THIS PLAT AND SURVEY
TO BE CORRECT TO THE BEST OF
MY KNOWLEDGE.

Donald C. Baker
DONALD C. BAKER P.S. 6938
5958 T.R. 322
MILLERSBURG, OHIO 44654
PH. 216 674-4788
OCT. 28, 1993

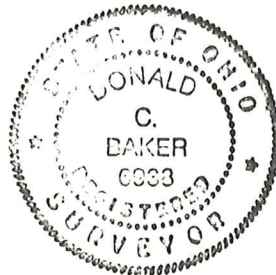

MAP OFFICE COPY