


- IRON PIN FOUND
- ▲ R.R. SPIKE FOUND
- △ R.R. SPIKE SET
- 5/8" REBAR WITH ID. CAP SET  
ID. CAP MARKED "BAKER 693B"

SURVEYED FOR: LOU BLECHA

**REFERENCES:**

- DEED VOL. 210 PAGE 607
- DEED VOL. 114 PAGE 465
- DEED VOL. 161 PAGE 550
- DEED VOL. 261 PAGE 15
- DEED VOL. 210 PAGE 603
- PLAT VOL. 8 PAGE 653

**KNOX TOWNSHIP**  
**2ND. QTR., LOT 2**  
**T-9N; R-9W**  
**HOLMES COUNTY, OHIO**

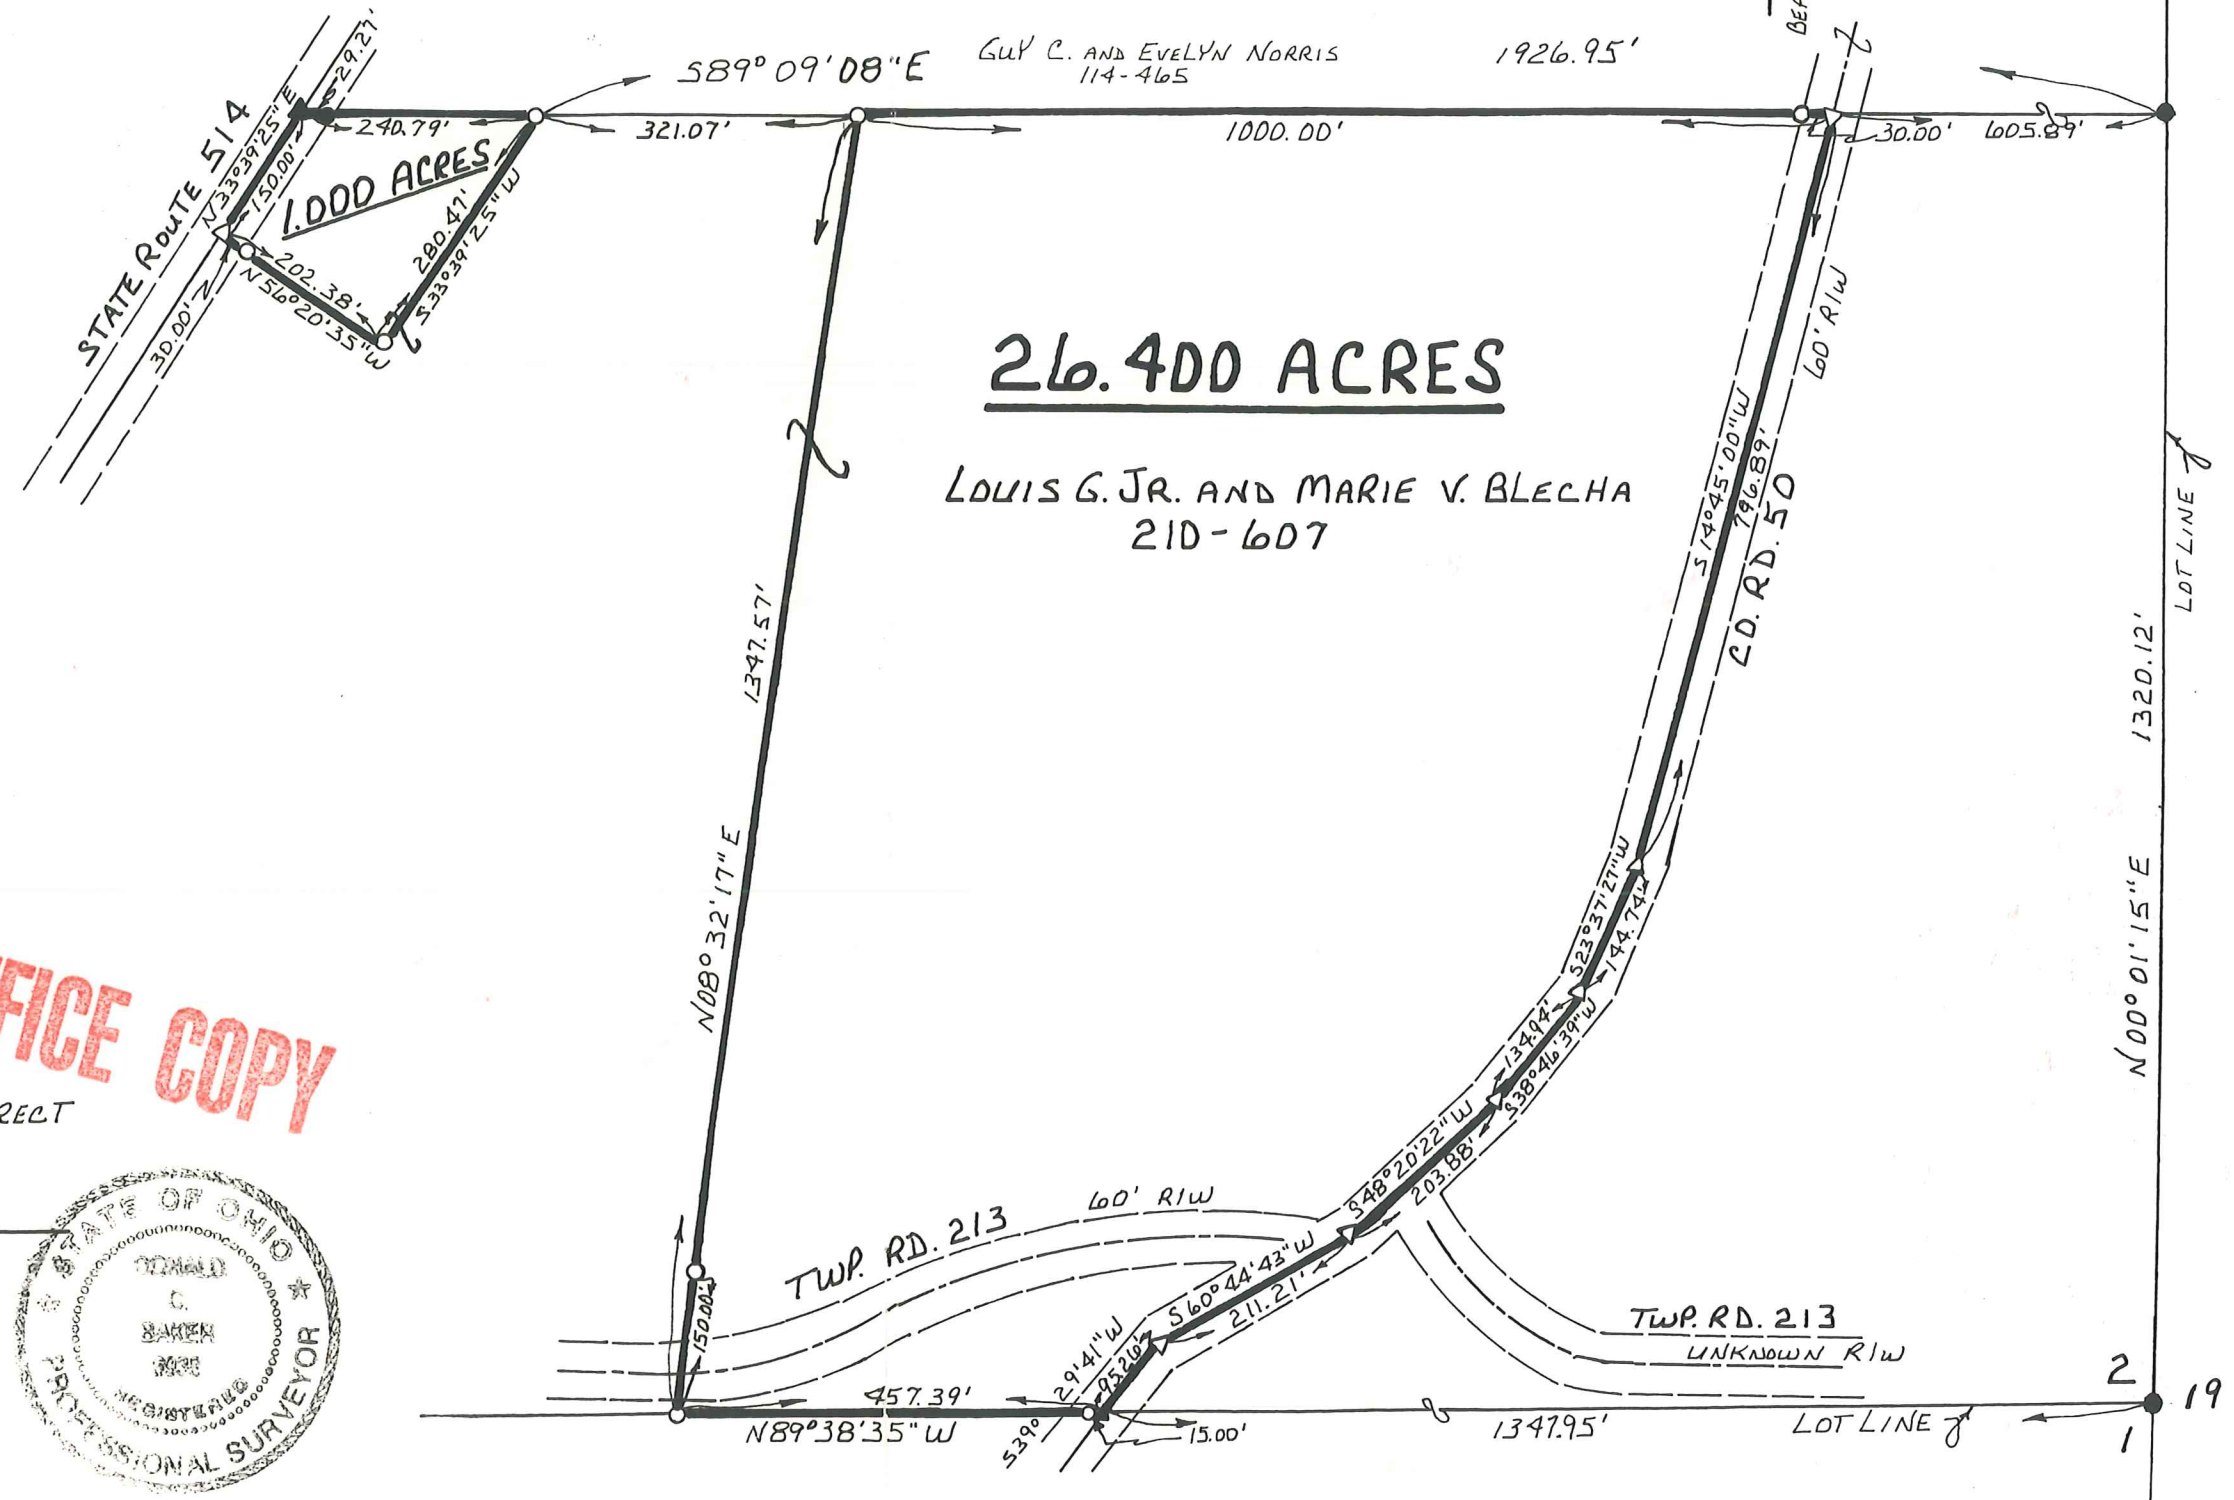

**MAP OFFICE COPY**

I CERTIFY THIS SURVEY TO BE CORRECT  
 TO THE BEST OF MY KNOWLEDGE.

*Donald C. Baker*

DONALD C. BAKER P.S. 6938

5958 T.R. 322

MILLERSBURG, OHIO 44654

PH. (330) 674-4788

AUGUST 22, 1996

49396-SRU

