


KNOX TOWNSHIP
 HOLMES COUNTY, OHIO
 LOT 9, 4TH QTR., T-9N, R-9W

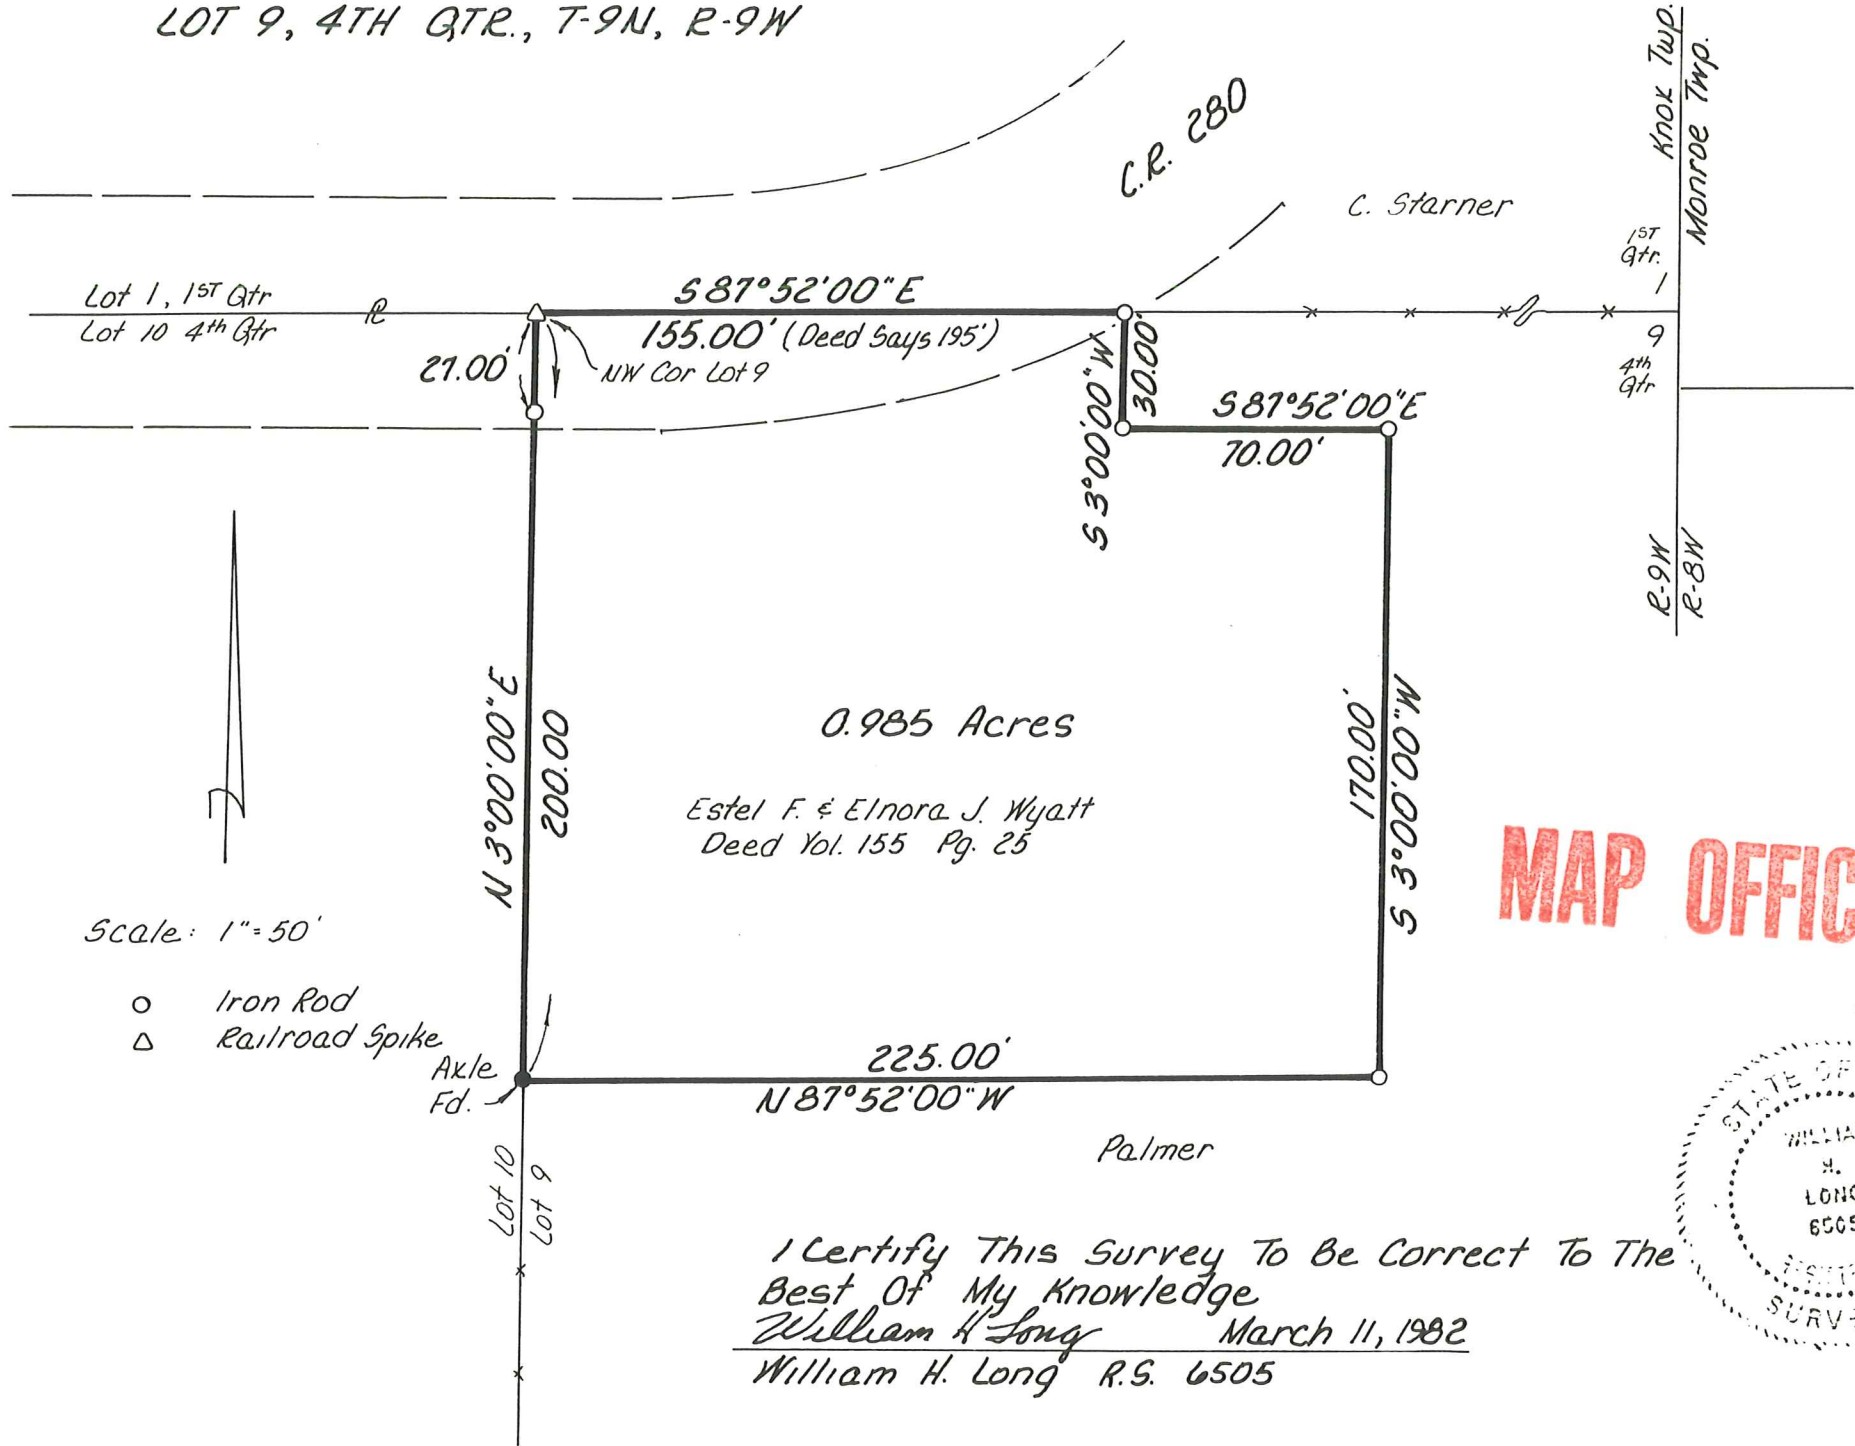

Scale: 1" = 50'

- Iron Rod
- △ Railroad Spike

MAP OFFICE COPY



I Certify This Survey To Be Correct To The
 Best Of My Knowledge
William H. Long March 11, 1982
 William H. Long R.S. 6505