

- IRON PIN FOUND
- 5/8" REBAR WITH I.D. CAP SET
- I.D. CAP MARKED "BAKER 6938"

REFERENCES:

- PLAT VOL. 4 PAGE 196
- PLAT VOL. 5 PAGE 80
- DEED VOL. 169 PAGE 577
- PLAT VOL. 6 PAGE 105
- DEED VOL. 176 PAGE 707
- BEARINGS FROM PLAT VOL. 6 PAGE 105





I CERTIFY THIS SURVEY TO BE CORRECT TO THE BEST OF MY KNOWLEDGE.

Donald C. Baker
 DONALD C. BAKER P.S. 6938
 4321 T.R. 252
 GLENMONT, OHIO 44628

NOVEMBER 11, 1991

MAP OF THE COPY

KNOX TOWNSHIP
 4TH. QTR. LOT 16
 T-9N; R-9W
 HOLMES COUNTY, OHIO

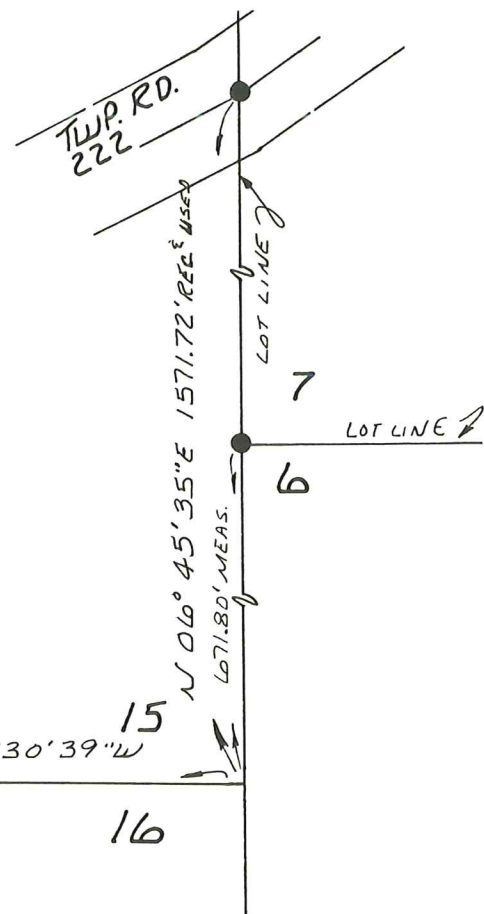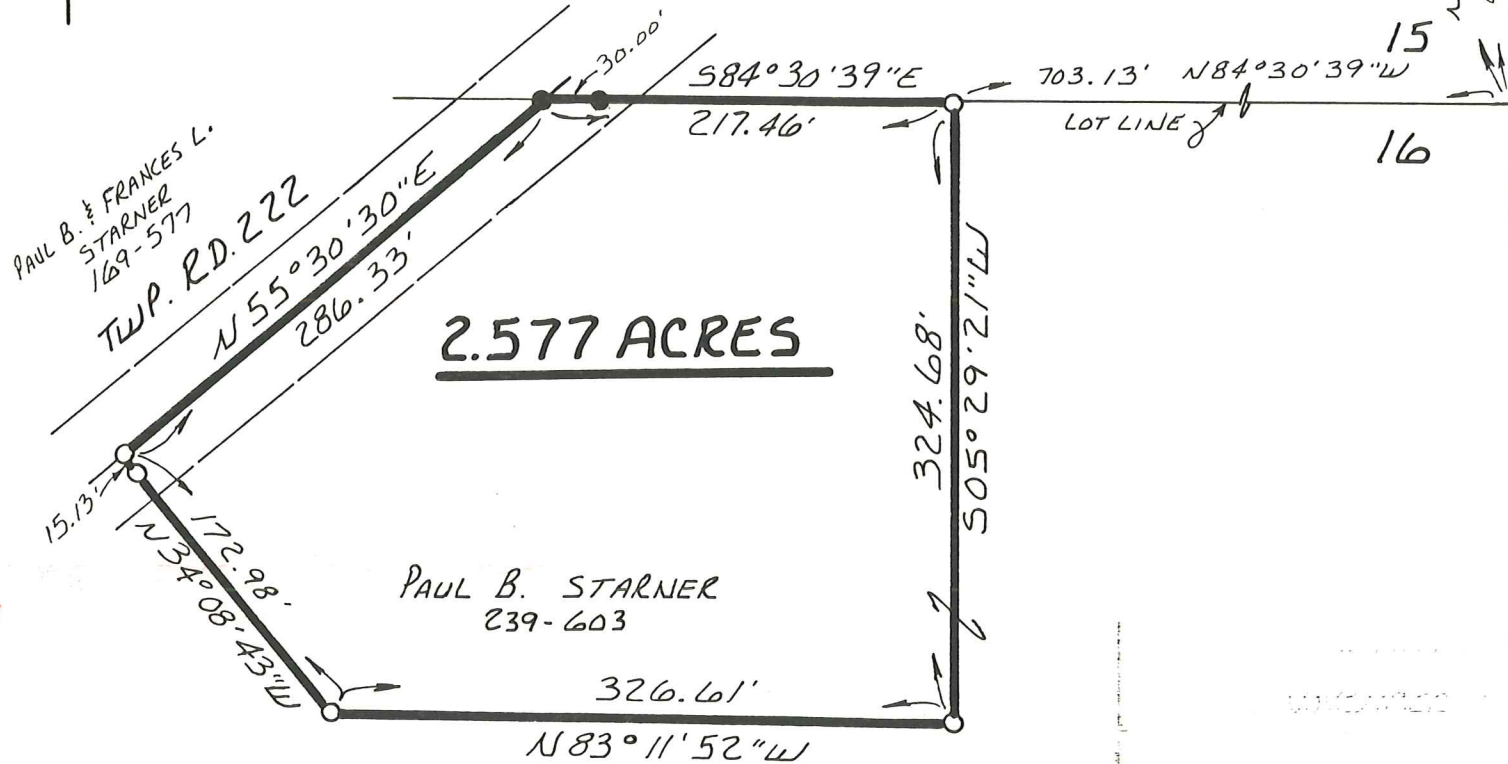

1975-MLS