

KNOX TOWNSHIP
4TH. QTR., LOT 25
T-9 N; R-9 W
HOLMES COUNTY, OHIO

SURVEYED FOR: JOSH LANDFAIR

REFERENCES

DEED VOL. 235 PAGE 123

O.R. VOL. 176 PAGE 1115

O.R. VOL. 178 PAGE 1775



PLAT VOL. 5 PAGE 27

PLAT VOL. 6 PAGE 71

PLAT VOL. 11 PAGE 143

PLAT VOL. 17 PAGE 498

BEARINGS FROM PLAT VOL 17 PAGE 498

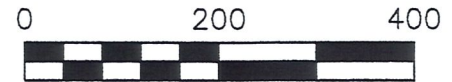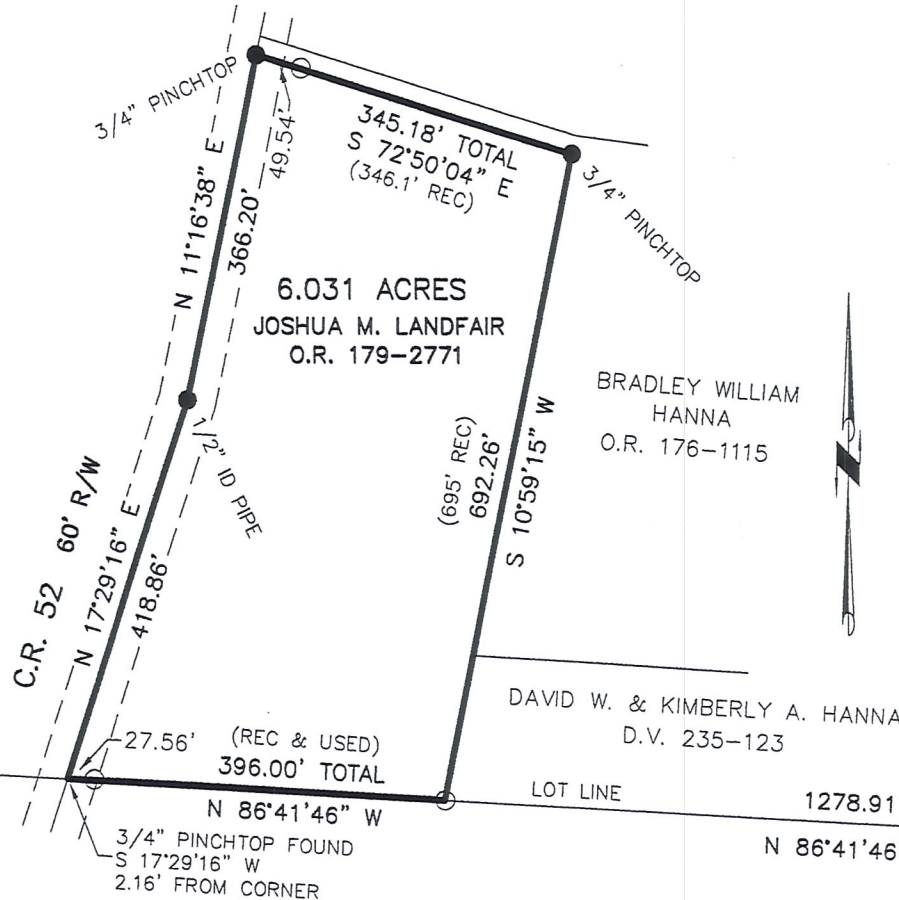


SCALE: 1"=200'

- 5/8" REBAR FOUND UNLESS OTHERWISE NOTED
- 5/8" REBAR WITH I.D. CAP SET I.D. CAP MARKED "BAKER 6938"



DAVID W. & KIMBERLY A. HANNA
D.V. 235-123

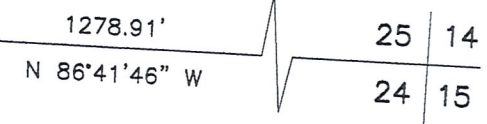

MAP OFFICE COPY

I CERTIFY THIS SURVEY TO BE CORRECT TO THE BEST OF MY KNOWLEDGE

Donald C. Baker

DONALD C. BAKER P.S. 6938

DATE: APRIL 29, 2005

KES\AEG
File Name: WORK2\S-203-05\ERZ



DONALD C. BAKER SURVEYING
138 N. CLAY ST.
MILLERSBURG, OHIO, 44654
PH. 330-674-4788
FAX. 330-674-6027