
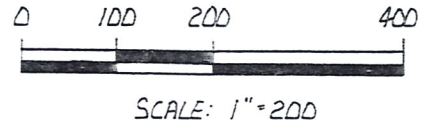


LOT LINE
1187.25' USED

15 | 9

KNOX TOWNSHIP 4TH QTR.
LOT 29 T-9N: R-9W
HOLMES COUNTY, OHIO

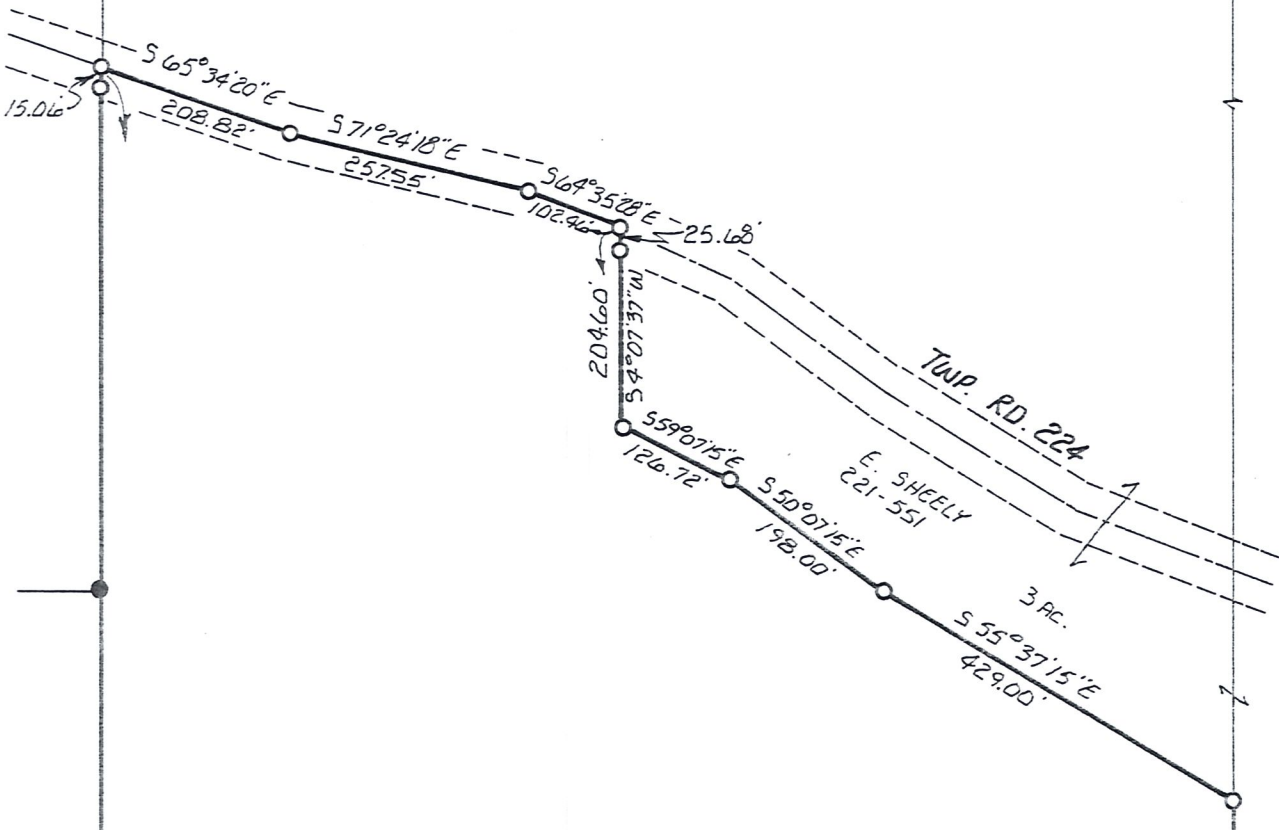

- CORNER STONE FOUND
- IRON PIN FOUND
- 5/8" RE-BAR WITH I.D. CAP SET

REFERENCES:

SURVEY RECORD 4 PAGE 64
PLAT VOL. 7 PAGE 482
BEARINGS FROM SAME
VARIOUS DEEDS AS SHOWN

TERRY E. & M. MILLER SAURER
DEED VOL. 198 PAGE 223
" " 197 " 423

66.356 ACRES

MAP OFFICE COPY



I CERTIFY THIS SURVEY TO BE
CORRECT TO THE BEST OF MY
KNOWLEDGE.

Donald C. Baker
DONALD C. BAKER P.S. 6938
4321 T.R. 252
GLENMONT, OH.

JULY 3, 1987

30 29 1178.94' 29 28 1178.94' 28 27
N 85° 44' 54" W LOT LINE