

BY J.E.K. DATE 1-22-80
 CHKD. BY R.G.R. DATE
 SUBJECT Jeff Park Survey
 SHEET NO. 1 OF 396
 JOB NO.

SURVEY 2.000 ACRE PARCEL


SW QTR. SEC. 14
 T-9-N, R-9-W
 Knox Township

HOLMES COUNTY, OHIO

Grantor - Margaret E. Park
 Vol. 132, Pg. 378
 Grantee - Jeff Park

Scale: 1" = 100'

● - I.P. Fd.
 ○ - I.P. Set

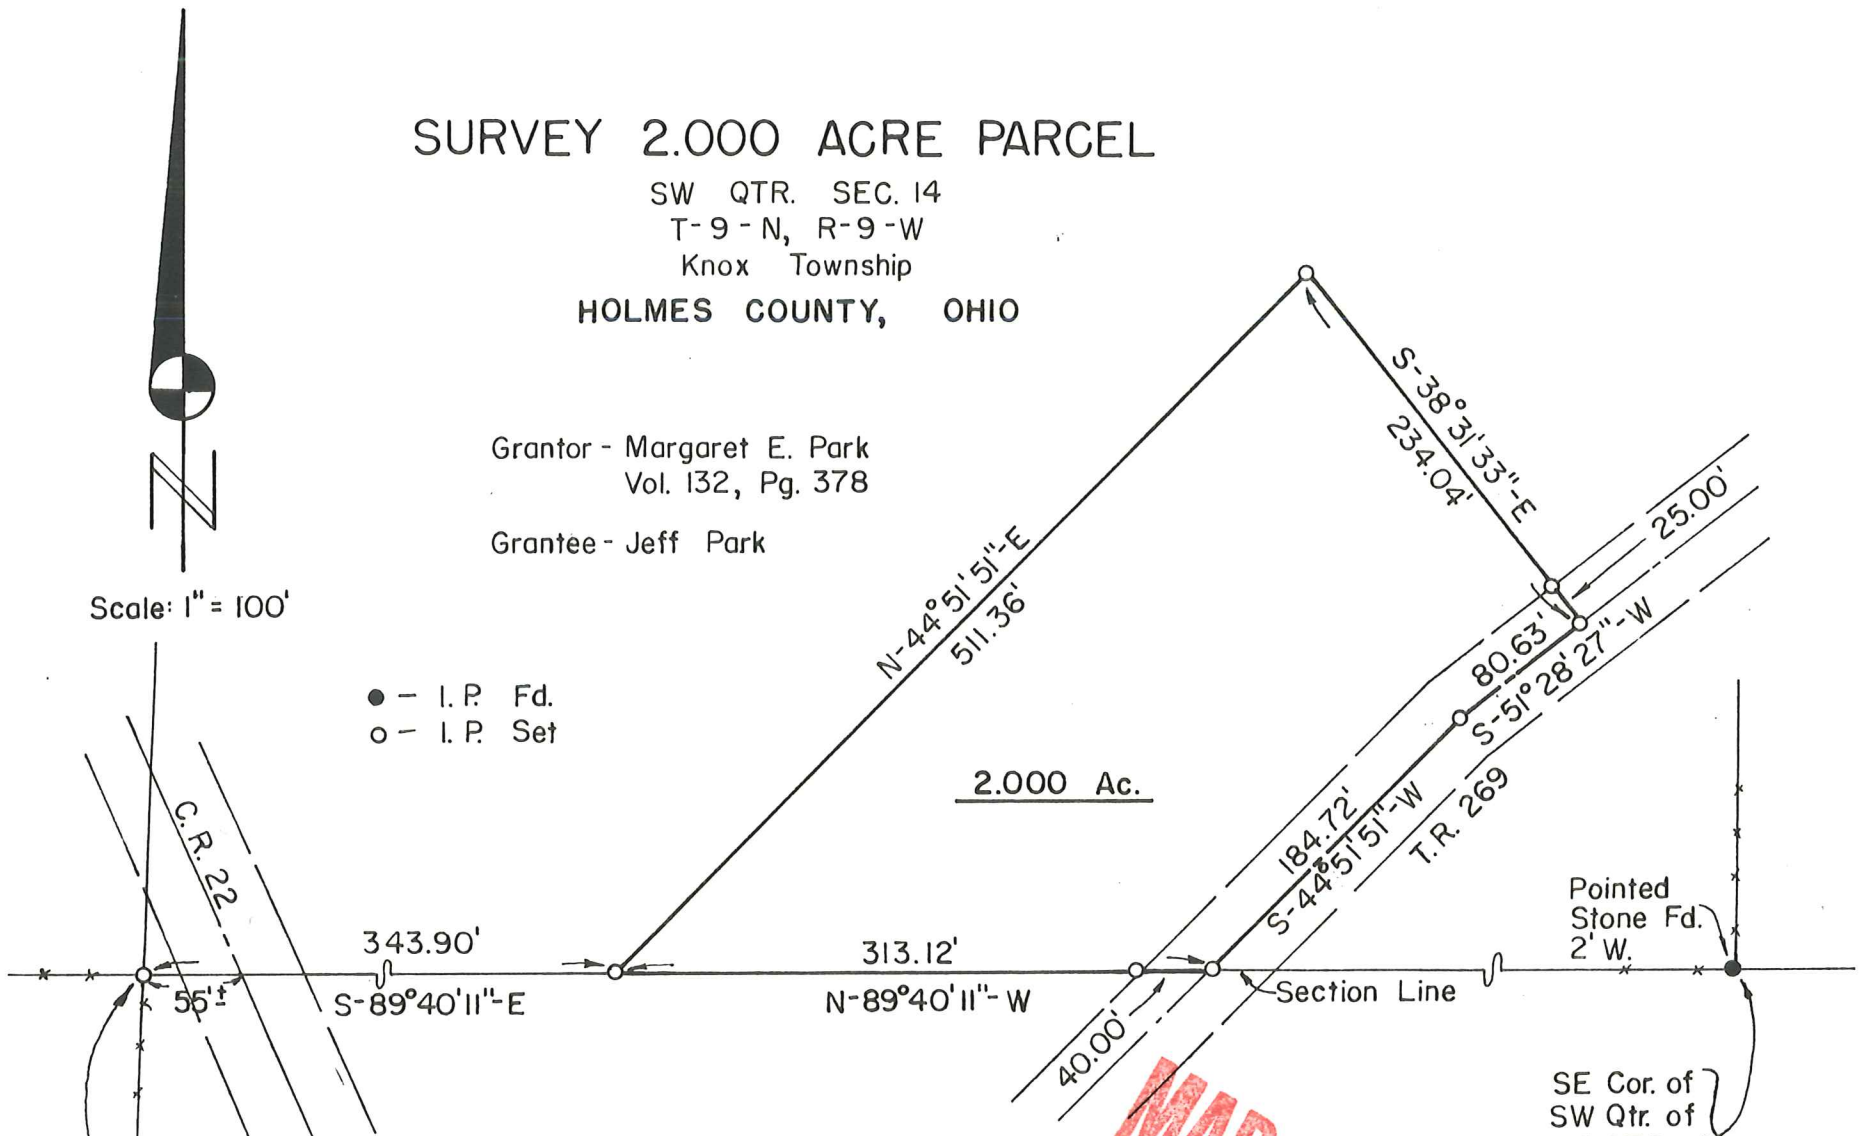


SW Cor. of
 SE Qtr. of
 SW QTR. of
 SEC. 14

I Certify This Survey And Plat To Be
 Correct To The Best Of My Knowledge.

1-22-80 *Ronald G. Rudolph*

Ronald G. Rudolph - R.S. 6449
 R.G. RUDOLPH SURVEYING, Inc.
 Wooster and Millersburg, Ohio

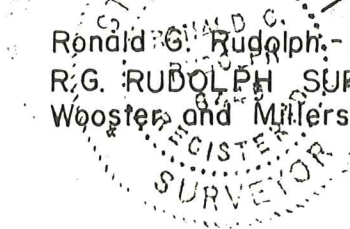

MAP OFFICE COPY

SE Cor. of
 SW Qtr. of
 SE QTR. of
 SEC. 14