


KNOX TOWNSHIP
2ND. QTR., LOT 5
S.E. QTR. FRACTIONAL
SECTION 14
T-9 N; R-9 W
HOLMES COUNTY, OHIO


SURVEYED FOR: DANIEL BURGETT

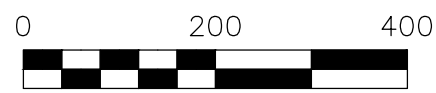

SCALE: 1"=200'


- STONE FOUND
- 5/8" REBAR FOUND
UNLESS OTHERWISE NOTED
- 5/8" REBAR SET WITH I.D. CAP
I.D. CAP MARKED "BAKER
SURVEYING LLC"

BASIS OF BEARINGS FROM OHIO STATE
PLANE COORDINATE SYSTEM, NORTH ZONE,
N.A.D. 83, 2011 ADJUSTMENT

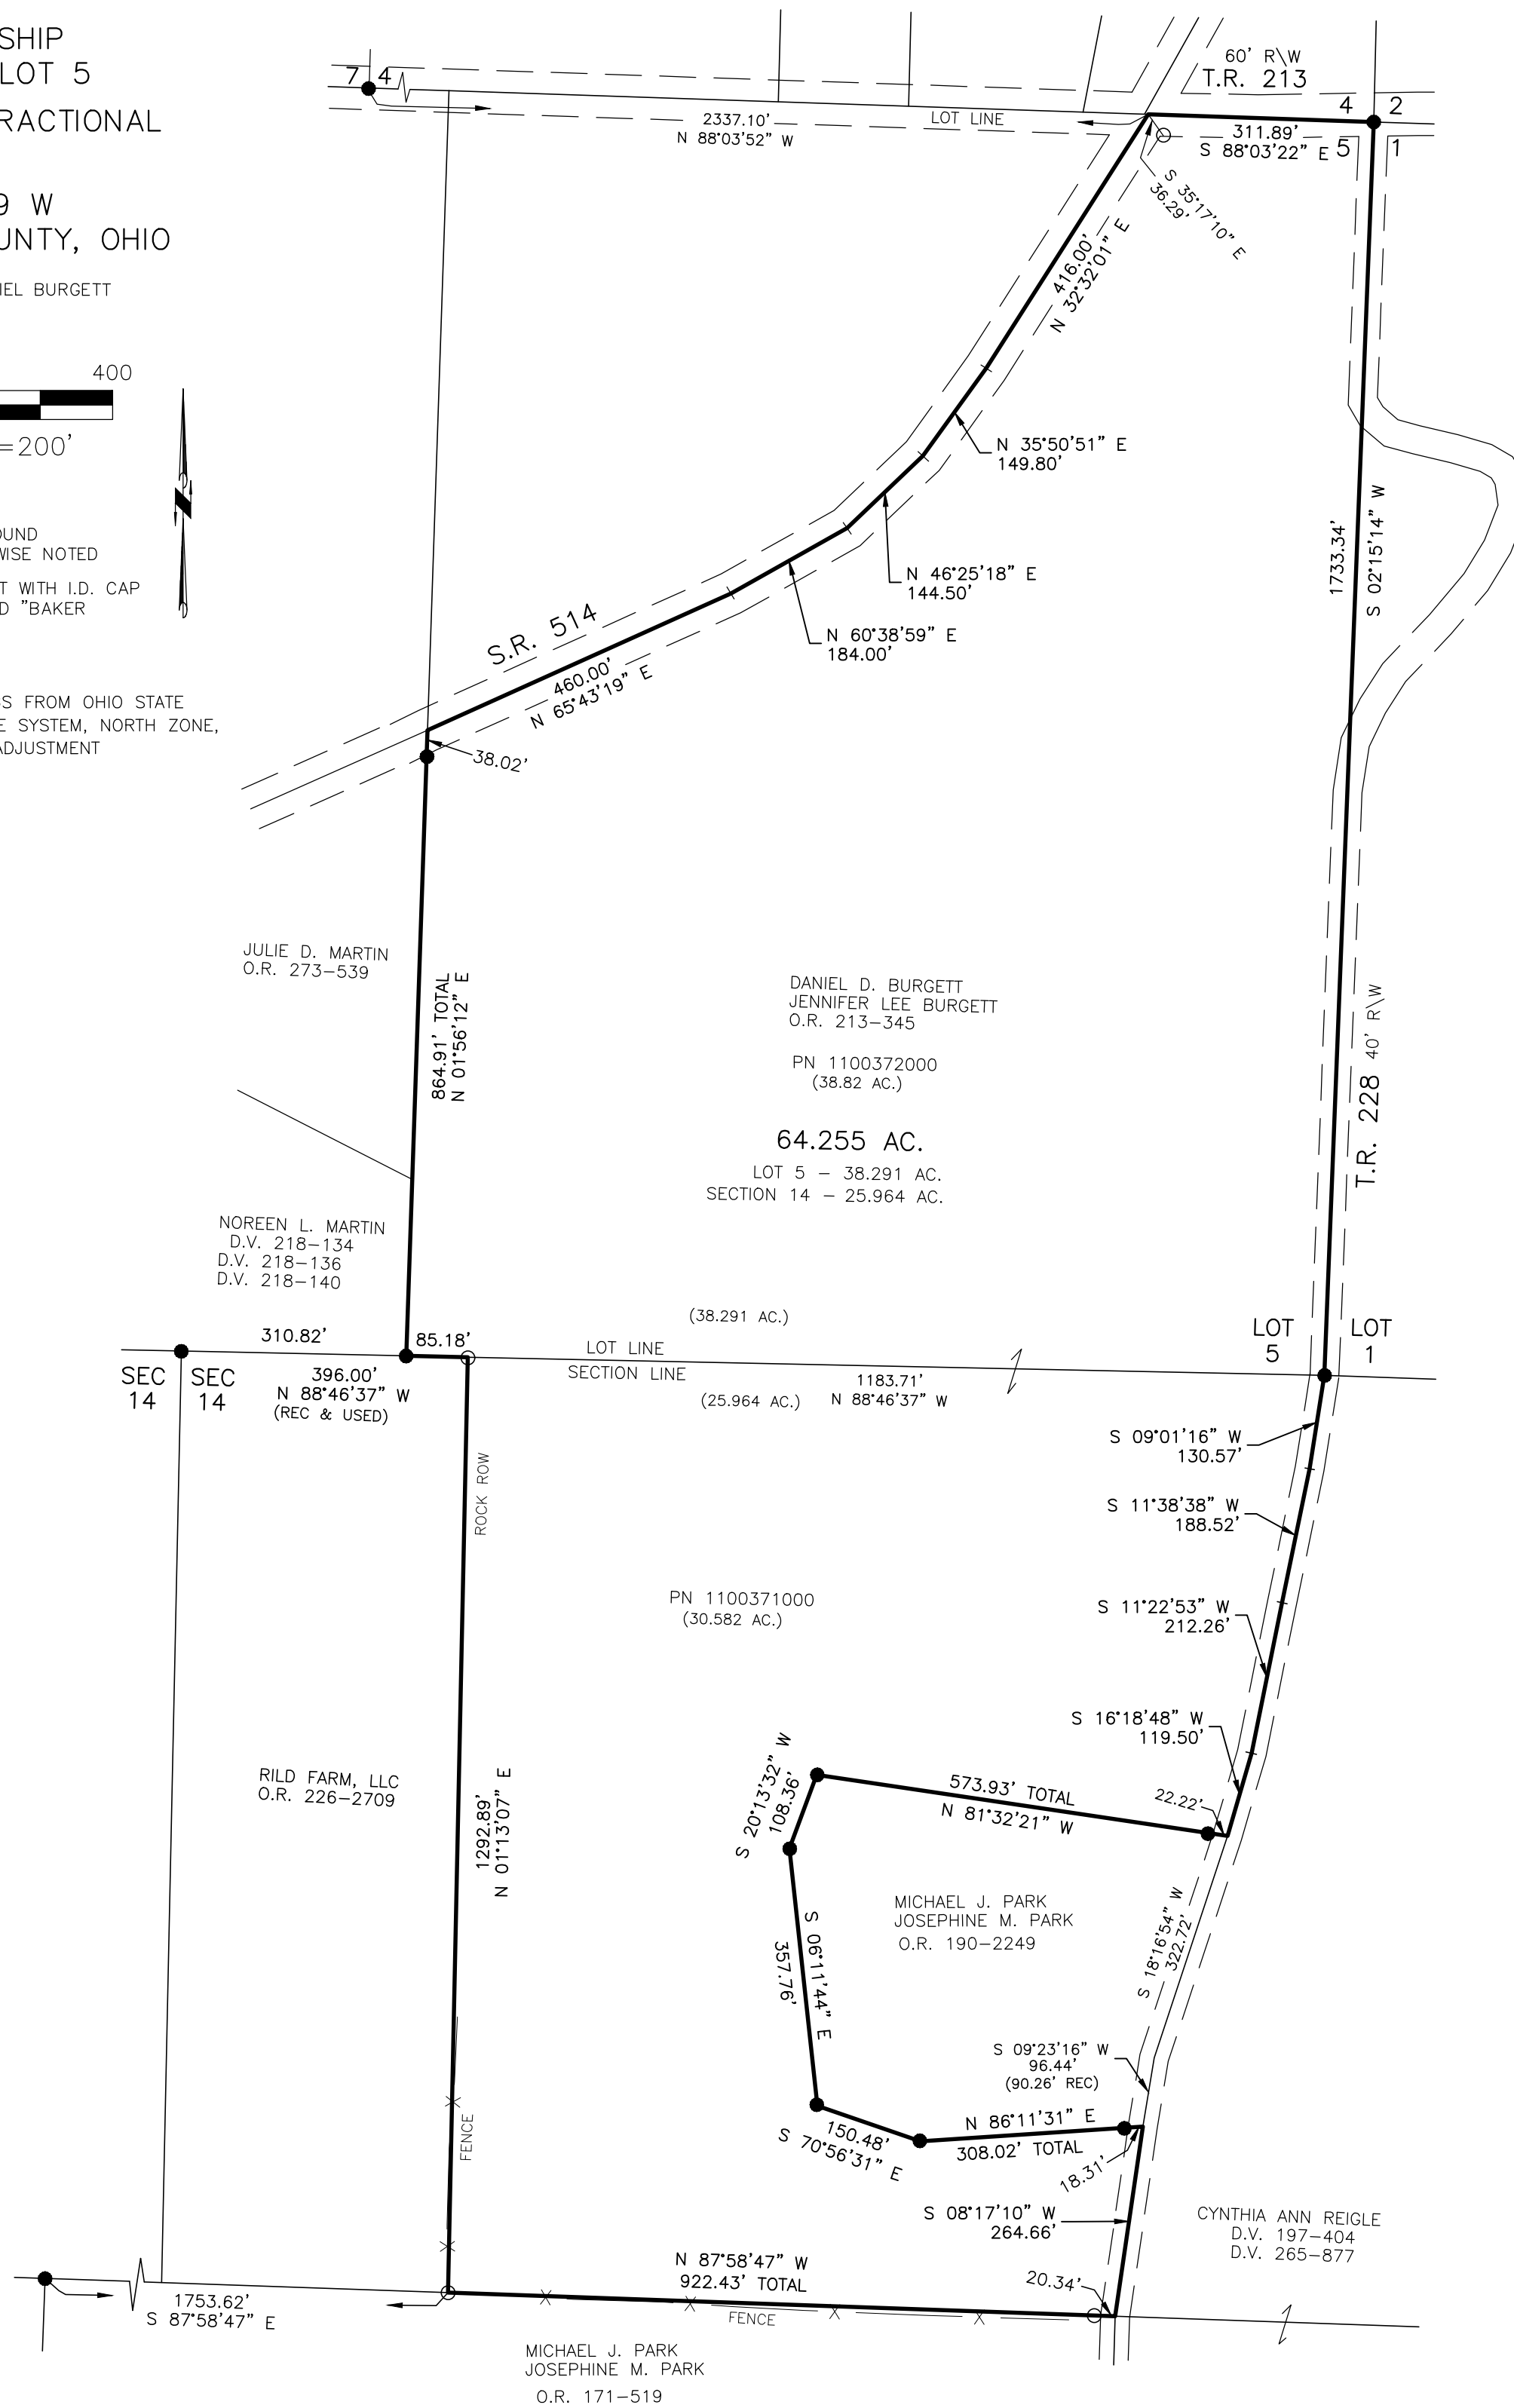

I CERTIFY THIS SURVEY TO BE CORRECT
TO THE BEST OF MY KNOWLEDGE.

Donald C. Baker
DONALD C. BAKER P.S. 6938
DATE: DECEMBER 2, 2025
TAB
FILE NAME: WORK7\S-565-25

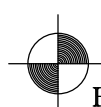

BAKER SURVEYING, LLC
138 N. CLAY STREET
MILLERSBURG, OHIO 44654
PH. 330-674-4788
EMAIL: bakersurveying@gmail.com