


KNOX TOWNSHIP
 S.E. QTR. SECTION 16
 S.W., N.W. & N.E. QTRS. SECTION 17
 T-9 N; R-9 W
 HOLMES COUNTY, OHIO

SURVEYED FOR: KAUFMAN REALTY

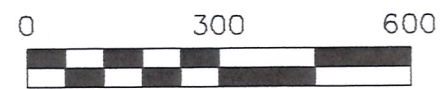


SCALE: 1" = 300'

- STONE FOUND
- P.K. NAIL FOUND
- 5/8" REBAR FOUND UNLESS OTHERWISE NOTED
- 5/8" REBAR SET WITH I.D. CAP I.D. CAP MARKED "BAKER 6938"
- △ R.R. SPIKE SET

REFERENCES

DEED VOL. 262 PAGE 513
 DEED VOL. 255 PAGE 410
 O.R. VOL. 248 PAGE 4284
 O.R. VOL. 171 PAGE 519
 O.R. VOL. 241 PAGE 2209
 BEARINGS FROM AN UNRECORDED SURVEY BY JAMIE D. DARR DATED JULY 11, 2008 (SURVEY WAS DONE FOR STITZLEINS)

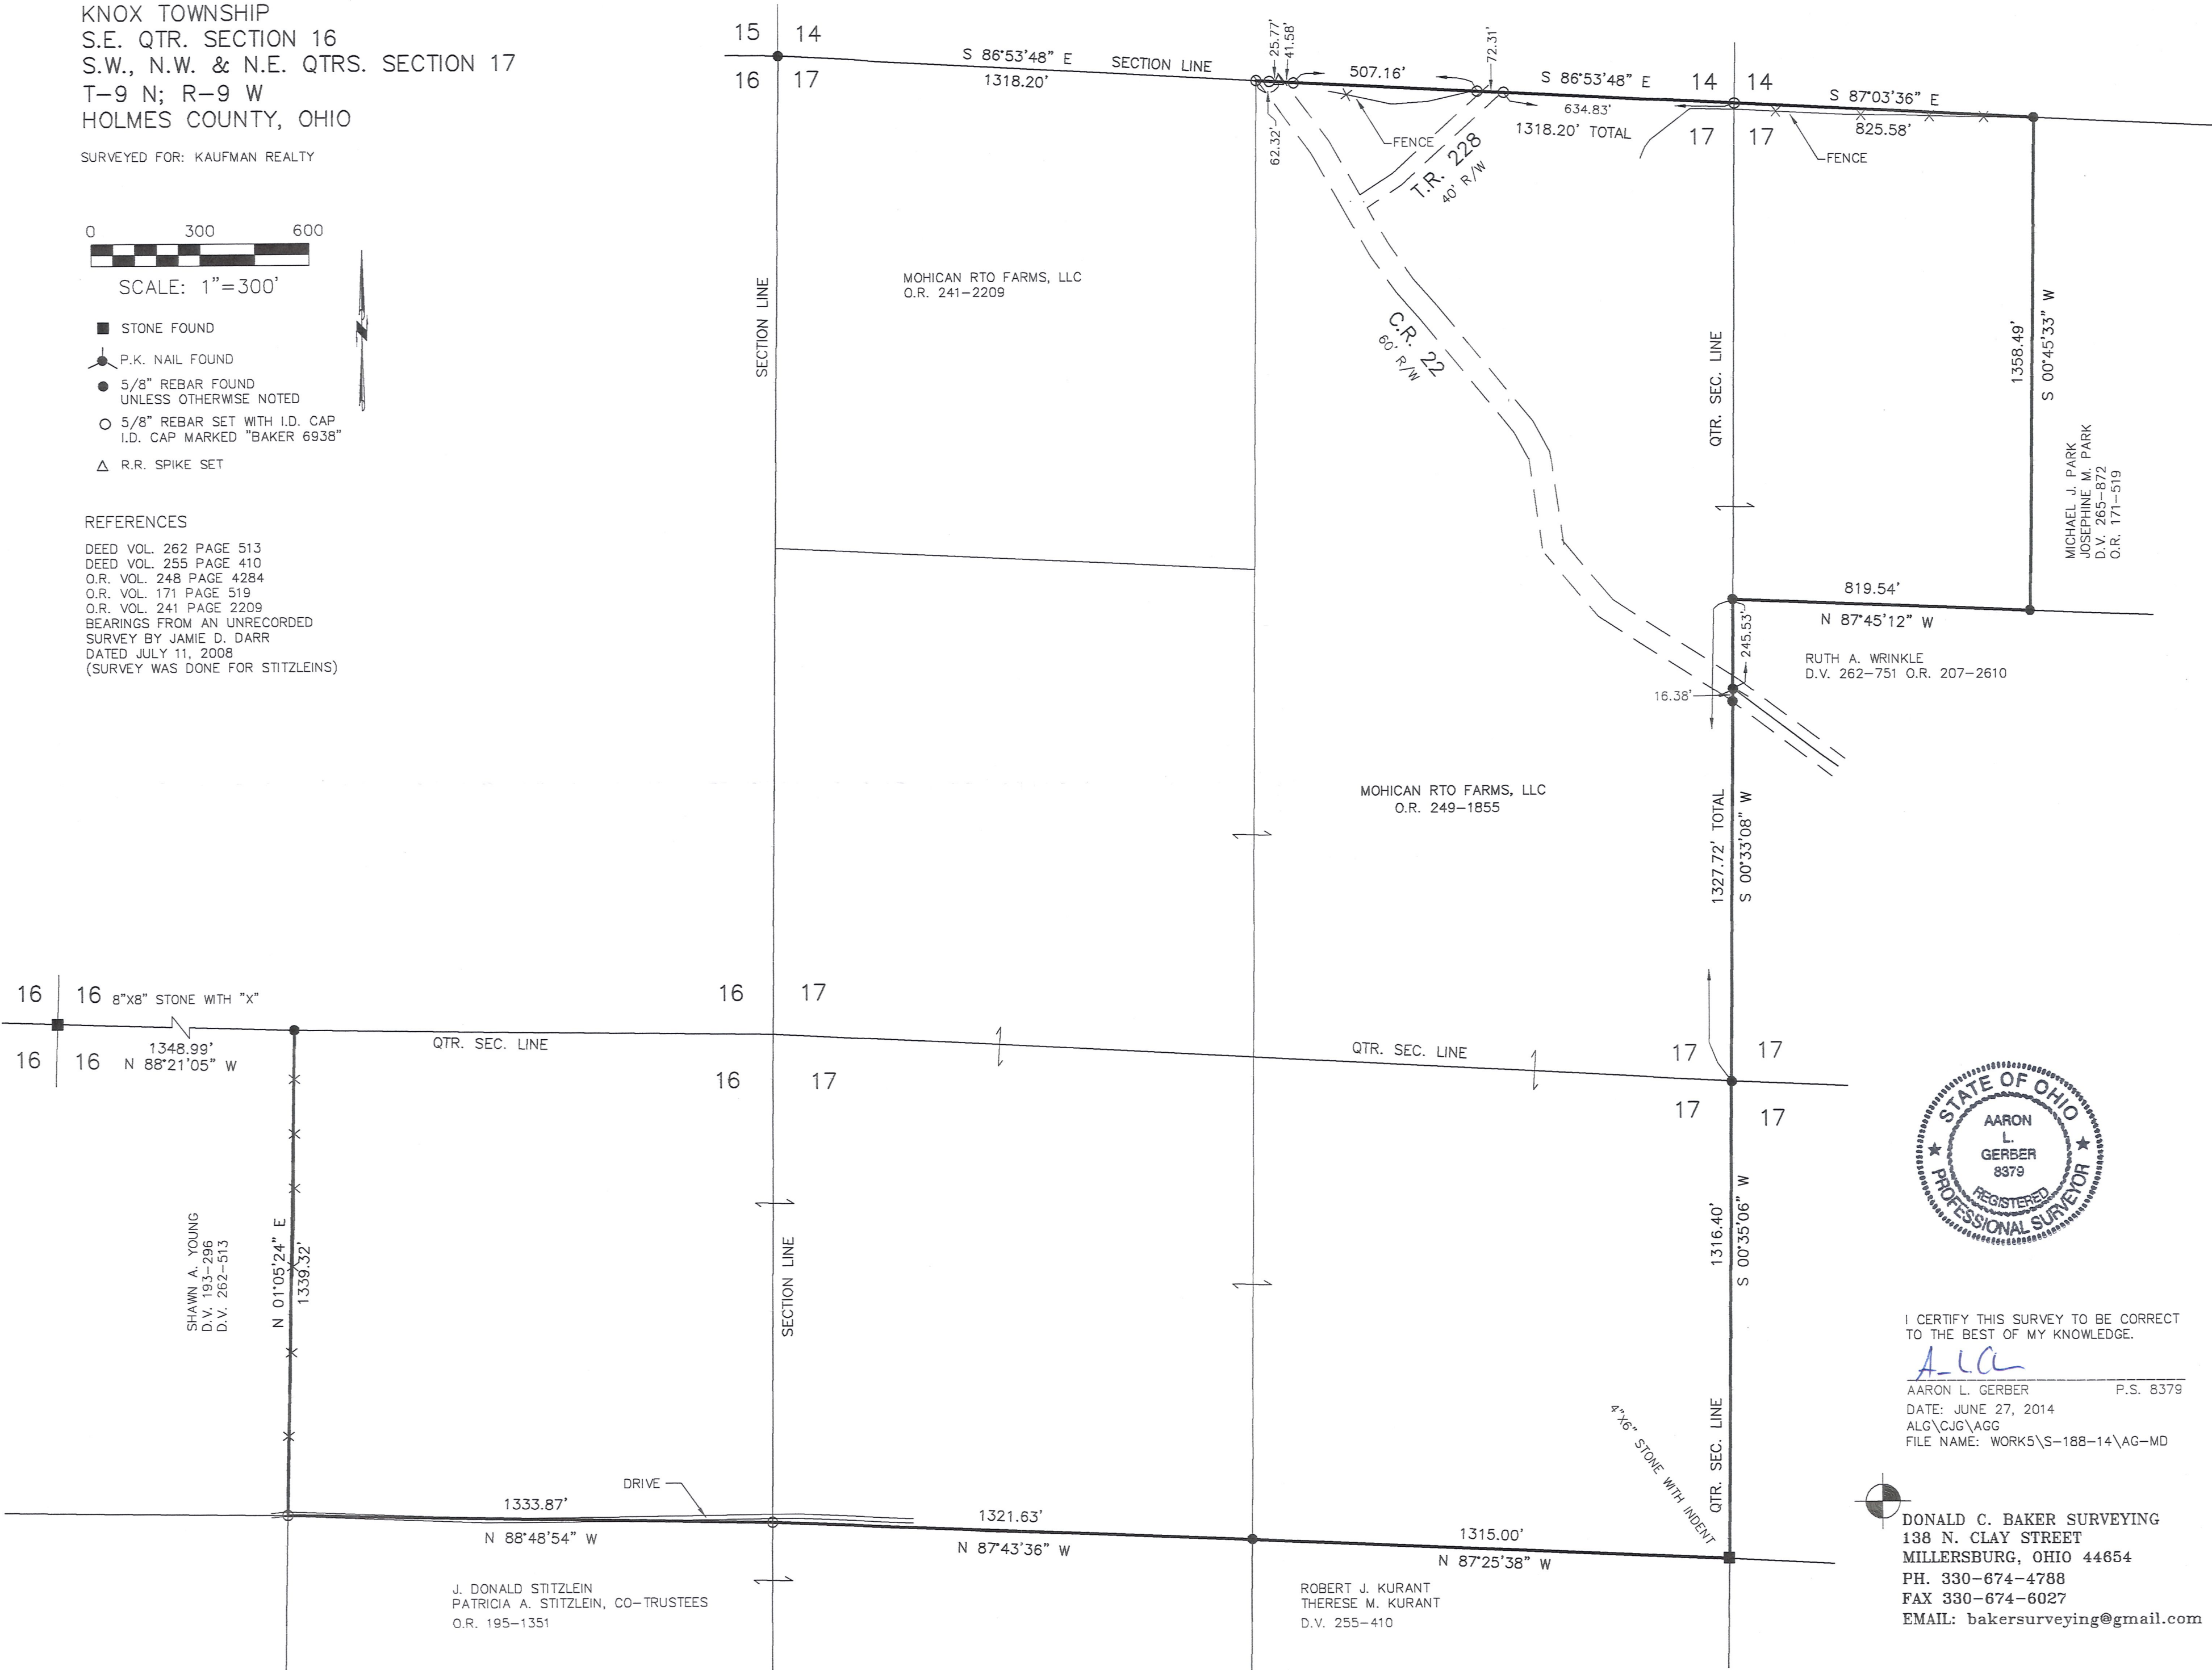

I CERTIFY THIS SURVEY TO BE CORRECT TO THE BEST OF MY KNOWLEDGE.
A.L.G.
 AARON L. GERBER P.S. 8379
 DATE: JUNE 27, 2014
 ALG\CJG\AGG
 FILE NAME: WORKS\S-188-14\AG-MD

DONALD C. BAKER SURVEYING
 138 N. CLAY STREET
 MILLERSBURG, OHIO 44654
 PH. 330-674-4788
 FAX 330-674-6027
 EMAIL: bakersurveying@gmail.com

