

LEGEND:

- = I.P. FOUND
- ⊗ = RAILROAD SPIKE FOUND
- = RAILROAD SPIKE SET
- △ = POST FOUND
- ⊗⊗⊗ = FENCE LINE FOUND
- = I.P. SET (5/8" X 30" RE-BARS W/PLASTIC CAPS STAMPED "JIM SHAMP 6088")
- M = MEASURED
- R = RECORD


DOCUMENTS:

- TAX MAPS
- AERIAL PHOTOS
- DEEDS AS SHOWN
- SURVEYS: VOL. 4, PG. 17
- VOL. 7, PG. 817
- VOL. 11, PG. 13
- S.R. 3-310
- 3-311
- 3-308
- 3-75
- 3-307

* BEARINGS ESTABLISHED FROM PLAT V. 7, P. 817

HEARTLAND Surveying			
Jim Shamp			
5210 Twp. Rd. 257 Millersburg, OH 44654			
Phone: 216-674-4698			
SURVEY JACKSON		DATE JUNE 15, 1992	
STATE OHIO	COUNTY HOLMES	TOWNSHIP KNOX	RANGE 9 WEST
TOWNSHIP 9 NORTH	4TH QTR., LOTS 32, 40 & 41		SECTION 18

I CERTIFY THIS TO BE A TRUE PLAT OF A FIELD SURVEY COMPLETED ON JUNE 15, 1992:

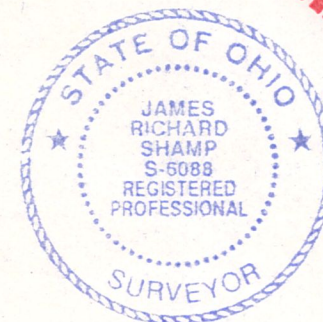

MAP OFFICE COPY

[Signature]
JIM SHAMP, REG. SUR. NO. S-6088

DORIS BILL & CAROL JEAN STEWART
V. 179, P. 406
ROBERT M. STEWART
V. 184, P. 348

DORIS NEISWANDER, V. 213, P. 556 L. EST.
JUDY A. HANNA, ET AL, V. 213, P. 556

