

RETRACEMENT SURVEY

MECHANIC TOWNSHIP  
2ND. QTR., LOTS 4 & 5  
T-8 N; R-6 W  
HOLMES COUNTY, OHIO  
SURVEYED FOR: JAMES MILLER

LOT 12  
LOT 13

6"X12" STONE  
FOUND  
IRON PIN SET  
ON EAST SIDE  
FOR REFERENCE

N 04°43'56" E  
601.78'

STAKES SET ALONG THIS LINE

NOTE:  
STAKES WERE SET ALONG THE NORTH, EAST AND SOUTH  
LINES OF THE 21.284 ACRE TRACT.

8"X12" STONE  
FOUND

LOT 6  
LOT 5

S 84°54'54" E

463.65'

LOT LINE

LOT 6  
LOT 5

LOT LINE

21.284 ACRES


LOT 4 - 6.513 AC.  
LOT 5 - 14.771 AC.

ATLEE J. and VIOLA MILLER  
D.V. 160-48  
D.V. 222-489  
JAMES A. MILLER  
D.V. 275-687

N 04°38'16" E  
1387.42'

1386.18'  
S 04°36'37" W

WAYNE COUNTY NATIONAL BANK, TRUSTEE  
D.V. 232-516

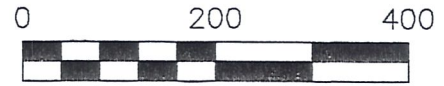

SCALE: 1"=200'

- STONE FOUND
- 5/8" REBAR FOUND UNLESS OTHERWISE NOTED
- 5/8" REBAR SET WITH I.D. CAP I.D. CAP MARKED "BAKER 6938"

REFERENCES

DEED VOL. 275 PAGE 687  
DEED VOL. 232 PAGE 516  
PLAT VOL. 16 PAGE 803  
BEARINGS FROM PLAT VOL. 16 PAGE 803

LOT 13  
LOT 14

(14.771 AC.)

LOT 5 S 85°04'05" E  
464.31'

LOT LINE

S 85°04'05" E  
191.07'

S 85°04'05" E  
2598.88' (CALC.)

LOT 5  
LOT 4

(6.513 AC.)

432.96'  
REC & MEAS.

432.87'  
S 05°10'08" W

432.52' (CALC.)  
S 04°33'53" W

REC & USED  
655.38'

N 85°04'33" W

2603.44'  
N 85°04'33" W

ROBERT A. and MARY JO PRESTON MILLER  
O.R. 14-129

N 05°10'08" E  
975.23'

STAKES SET ALONG THIS LINE

LOT 14  
LOT 15

LOT 4  
LOT 3

I CERTIFY THIS SURVEY TO BE CORRECT  
TO THE BEST OF MY KNOWLEDGE

DONALD C. BAKER P.S. 6938

DATE: OCTOBER 24, 2012

FDB\ALG\CJG

FILE NAME: WORK4\S-280A11-12\MLD

#532-12



DONALD C. BAKER SURVEYING  
138 N. CLAY STREET  
MILLERSBURG, OHIO 44654  
PH. 330-674-4788  
FAX 330-674-6027