

BEING PART OF: LOT 29 + 30
 SEC 2
 QUAR 2nd
 T 8 N. R 6 W 4. S. M. L.
 TOWNSHIP Mechanic
 COUNTY Holmes

THE COSHOCTON LAND SURVEYING SERVICE

233 S. FOURTH ST.

COSHOCTON, OHIO 43812

SURVEY FOR: Semac Industries, Inc.

DATE: October 1977


SCALE: 1" = 100'



O - Iron Pin Found
 - Iron Pin Set

MAP OFFICE COPY

Total Area = 25.380 ± Ac
 Lot 29 Area = 19.317 ± Ac
 Lot 30 Area = 6.063 ± Ac
 Being part of: Vol. 174, P. 474
 Exhibit A-2, Tracts 1 + 2
 (Call All Corp. to Semac Industries Inc.)

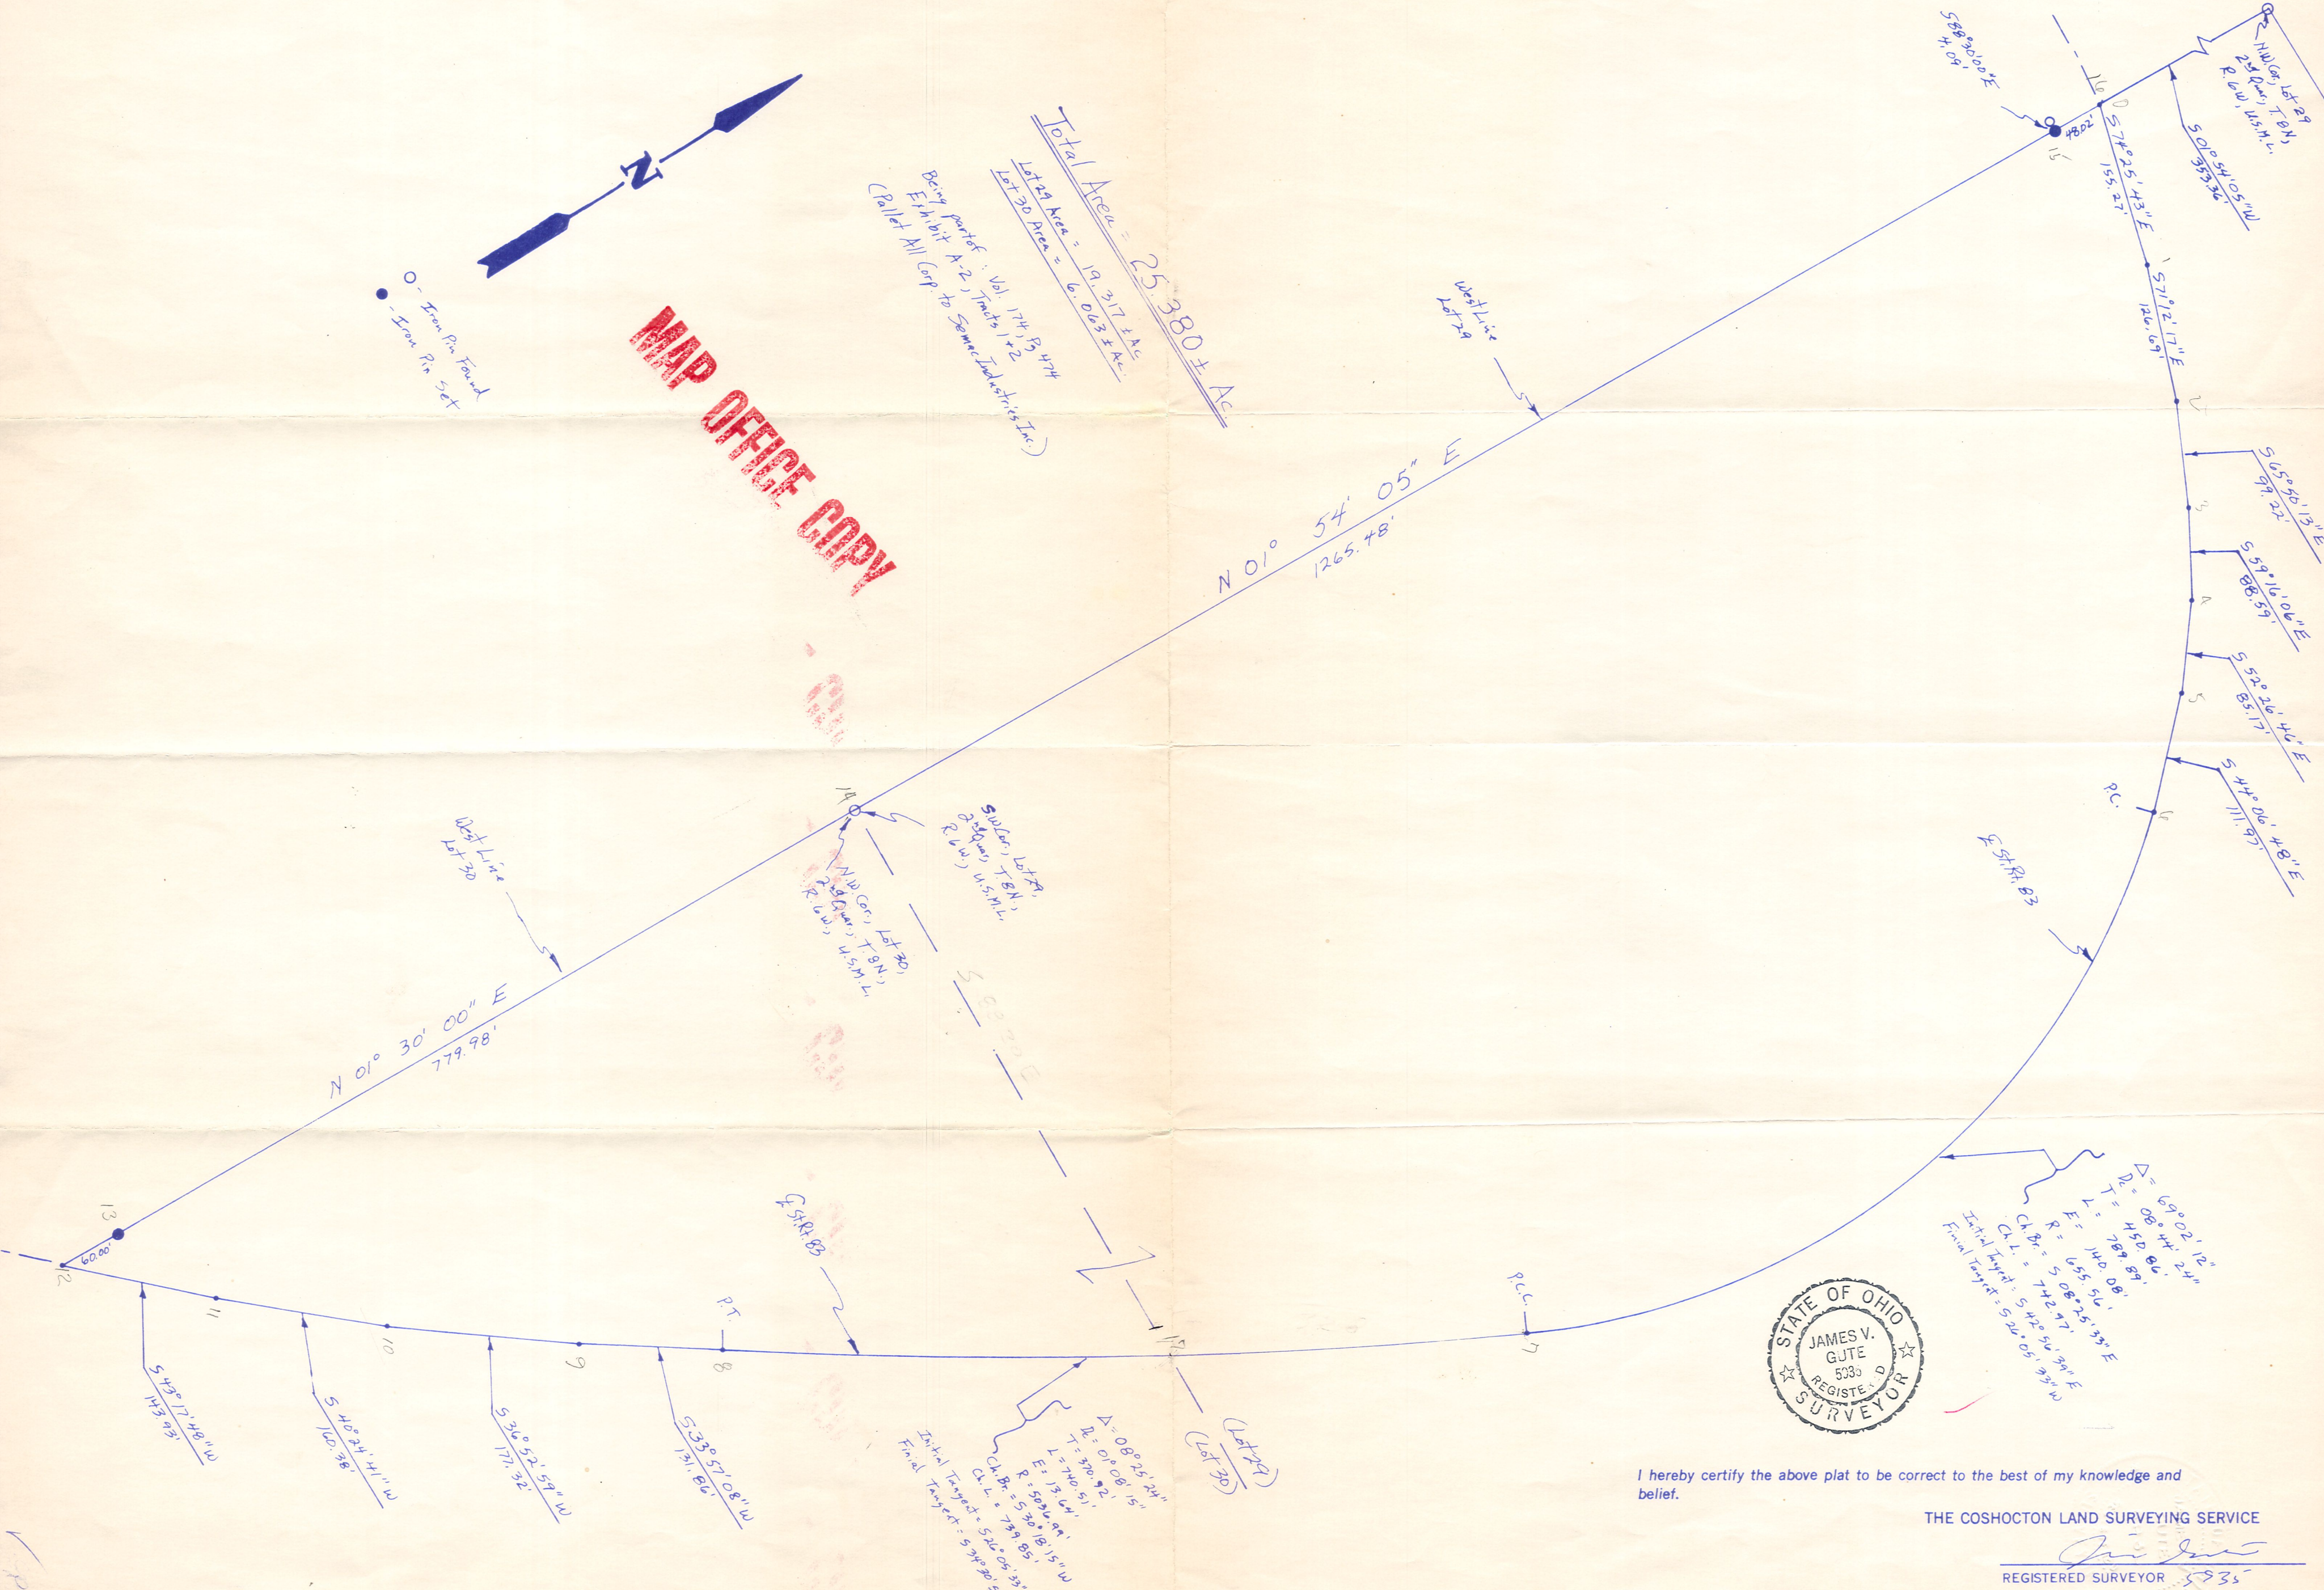

$\Delta = 69^{\circ} 02' 12''$
 $D = 08^{\circ} 44' 24''$
 $T = 450.86'$
 $L = 789.89'$
 $R = 655.56'$
 Initial Target = $S 42^{\circ} 50' 39'' E$
 Final Target = $S 24^{\circ} 05' 39'' W$

I hereby certify the above plat to be correct to the best of my knowledge and belief.

THE COSHOCTON LAND SURVEYING SERVICE

REGISTERED SURVEYOR 5835
 REGISTERED ENGINEER 37405

BRUNING 40-21 28409