

THE COSHOCTON LAND SURVEYING SERVICE

233 S. FOURTH ST.


COSHOCTON, OHIO 43812

BEING PART OF: LOT 30
 SEC. ~
 QUAR. 2nd
 T&N, R6W U.S.M.L.
 TOWNSHIP Mechanic
 COUNTY Holmes.

SURVEY FOR: Semac Industries, Inc.

DATE: Sept. 23, 1977

SCALE: 1" = 100'

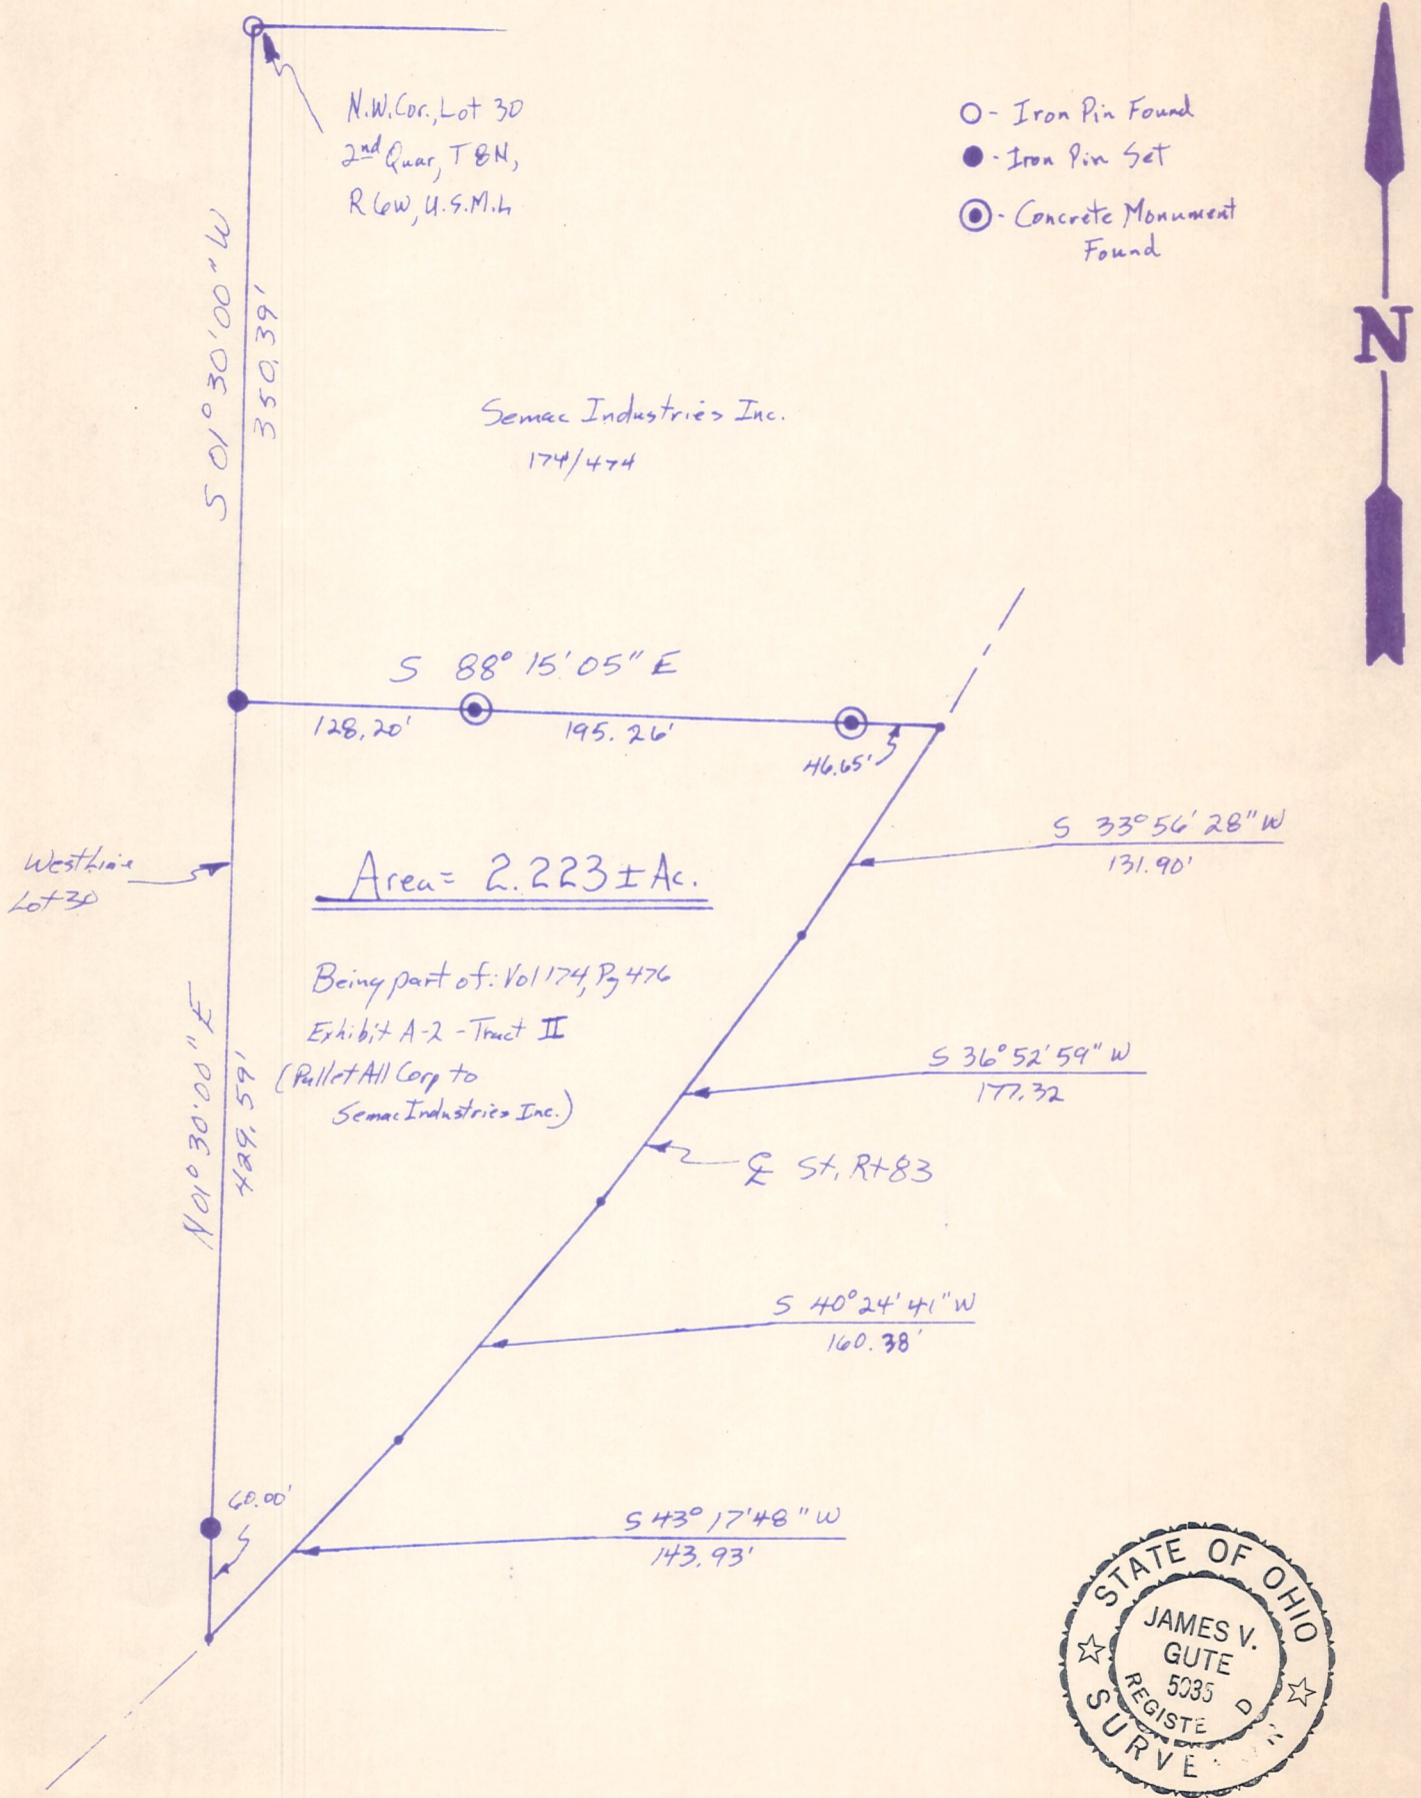

I hereby certify the above plat to be correct to the best of my knowledge and belief.

MAP OFFICE COPY

THE COSHOCTON LAND SURVEYING SERVICE

REGISTERED SURVEYOR *[Signature]* 5935