MECHANIC TOWNSHIP
3RD. QTR. LOT 10
T-8N ; R-6W
HOLMES COUNTY, OHIO

0 50 100 200

SCALE: 1" = 100'

- ■ STONE FOUND
- ▲ R.R. SPIKE FOUND
- ● IRON PIN FOUND
- △ R.R. SPIKE SET
- ○ 5/8" RE BAR WITH I.D. CAP SET

I.D. CAP MARKED "BAKER 6938"

REFERENCES:

PLAT VOL. 8 PAGE 539
PLAT VOL. 10 PAGE 20
DEED VOL. 242 PAGE 94
BEARINGS FROM DEED VOL. 175 PAGE 39

STATE OF OHIO
DONALD C. BAKER
6938
REGISTERED SURVEYOR

I CERTIFY THIS SURVEY TO BE CORRECT TO THE BEST OF MY KNOWLEDGE.

Donald C. Baker

DONALD C. BAKER P.S. 6938
4321 T.R. 252
GLENMONT OHIO 44628

AUGUST 30, 1991

1861-MLS
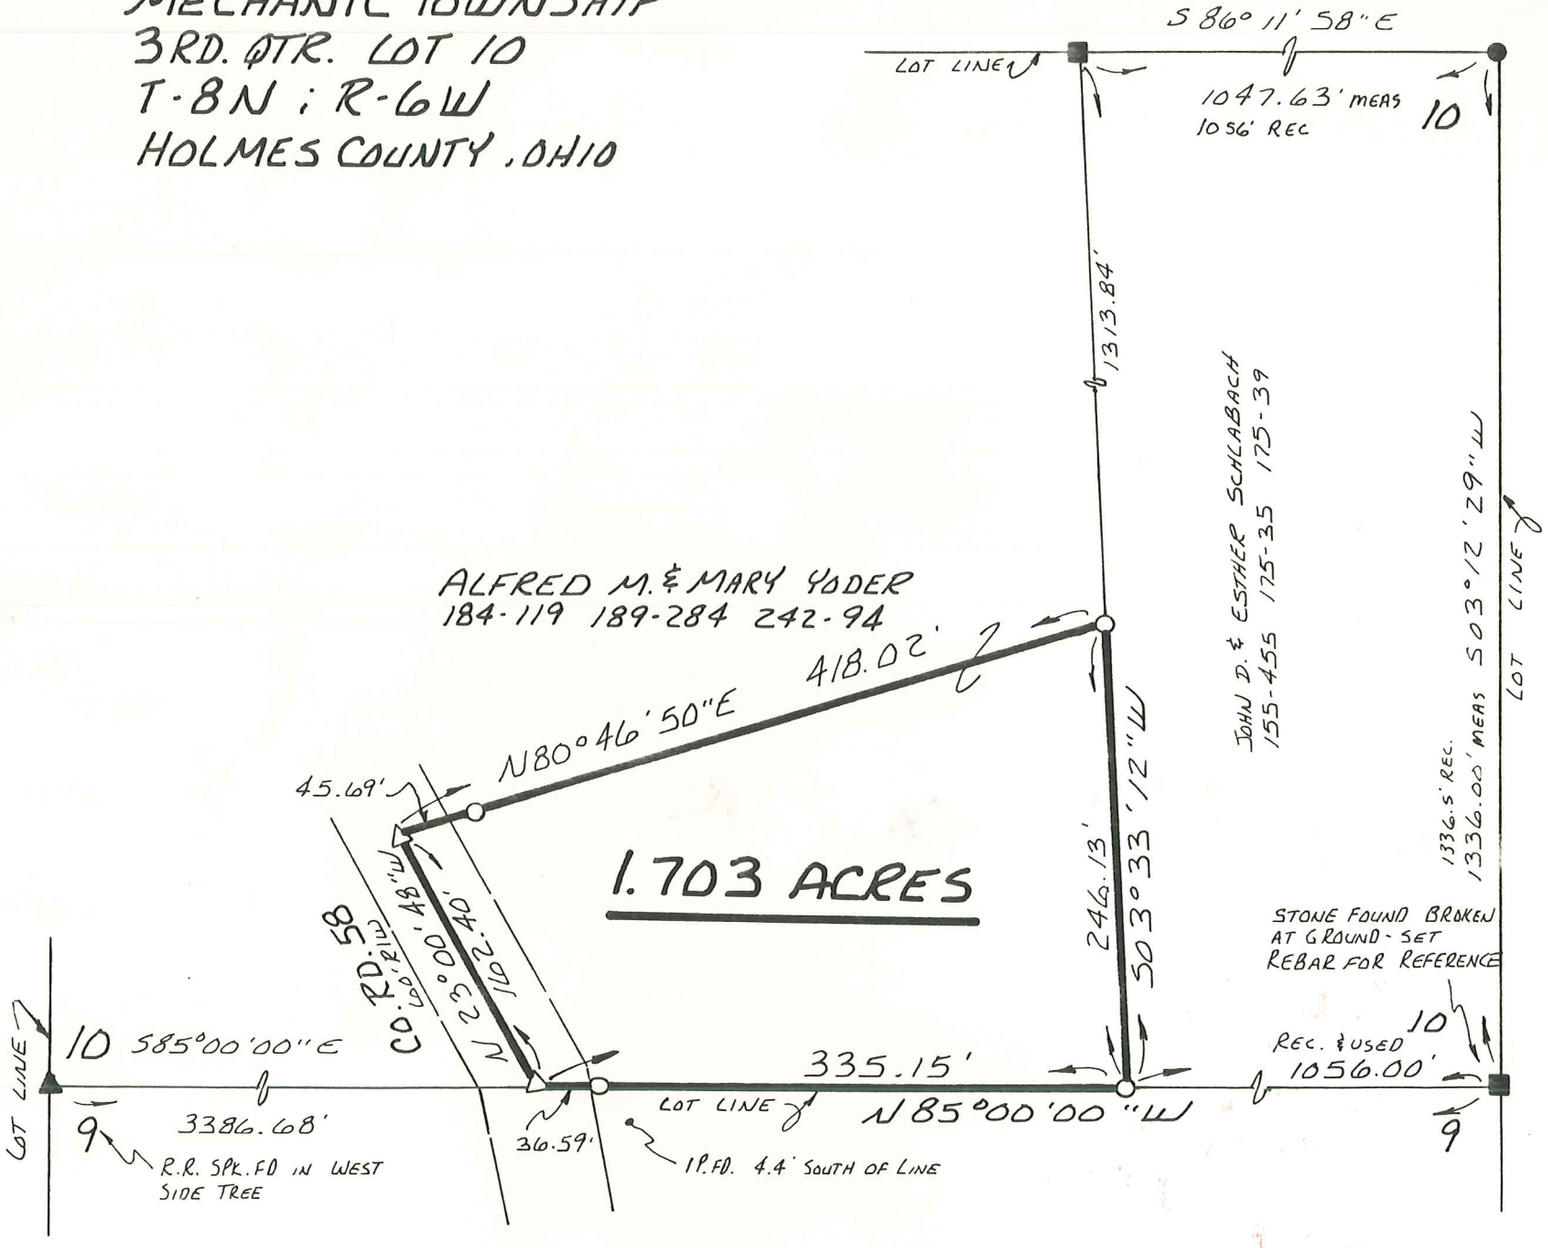
MAP OFFICE COPY