


- STONE FOUND
- 5/8" REBAR WITH I. D. CAP SET
- I. D. CAP MARKED "BAKER 6938"

MECHANIC TOWNSHIP
 3RD. QTR. LOT 25
 T-8N; R-6W
 HOLMES COUNTY, OHIO
 (SURVEYED FOR: BEN A. MILLER)

REFERENCES:
 DEED VOL. 221 PAGE 703
 " " 227 " 769

PLAT VOL. 11 PAGE 36
 BEARINGS FROM SAME.

RECEIVED
 MAR 20 2000
 Hol. Co. Tax Map Office

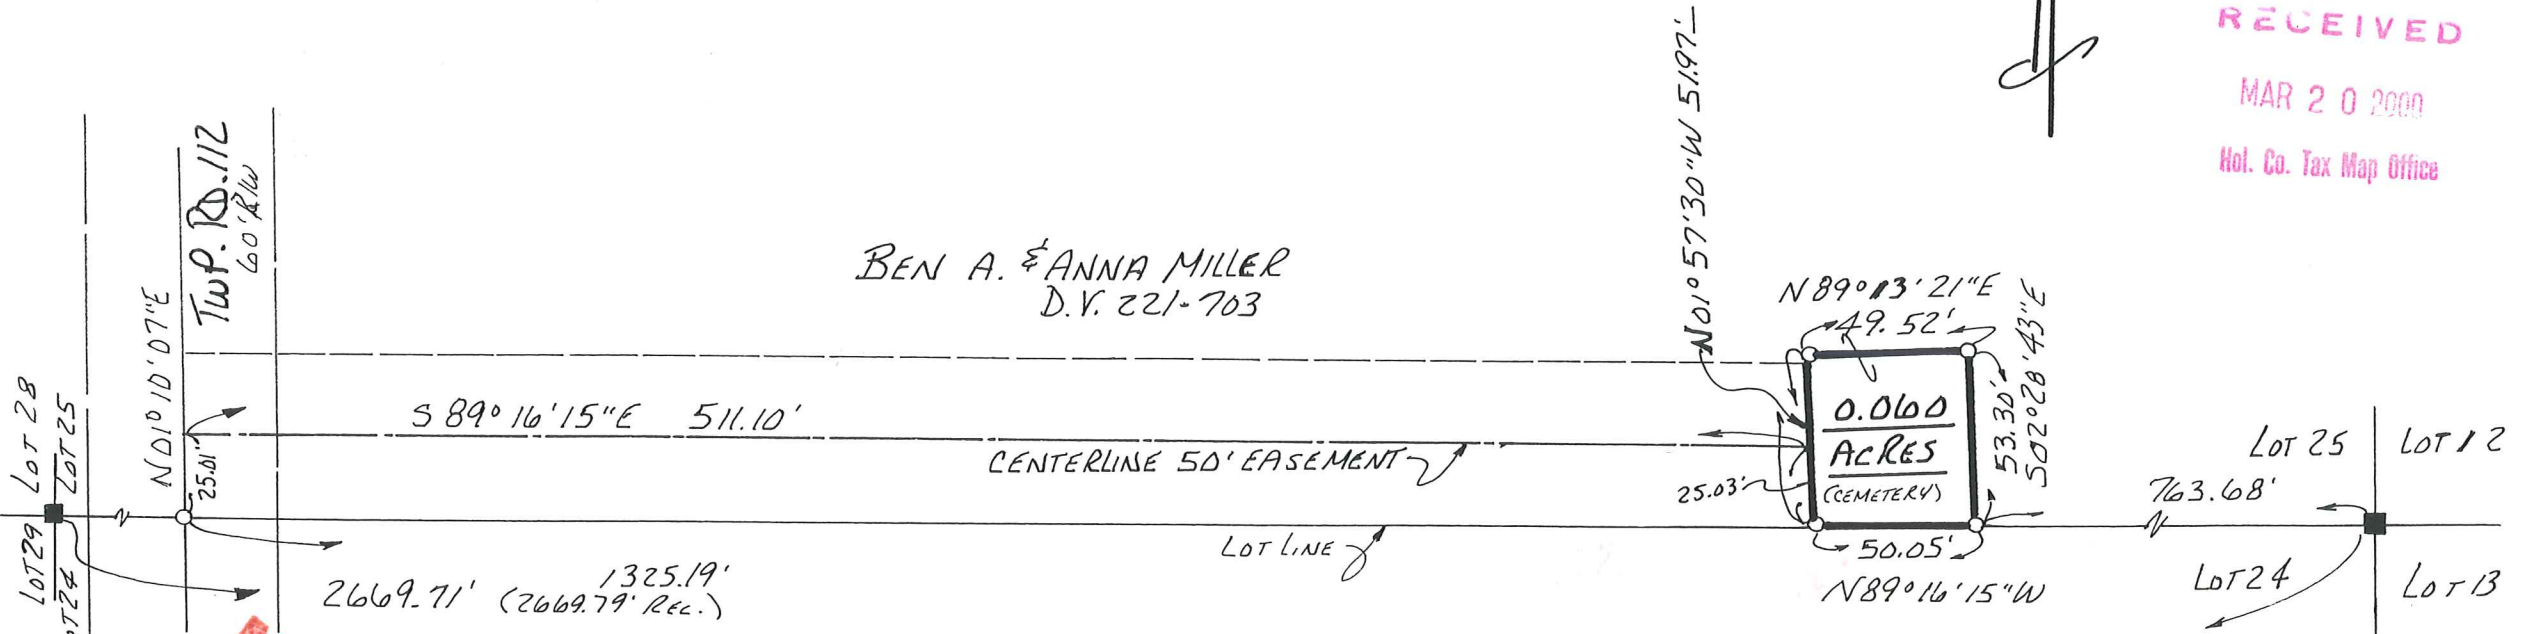

BEN A. & ANNA MILLER
 D.V. 221-703

I CERTIFY THIS SURVEY TO BE CORRECT
 TO THE BEST OF MY KNOWLEDGE.

Donald C. Baker

DONALD C. BAKER P.S. 6938
 DONALD C. BAKER SURVEYING
 138 N. CLAY ST.
 MILLERSBURG, OHIO 44654
 PH. (330) 674-4788
 MARCH 17, 2000
 #17800 - M.L. DAVIS
 F.C.C. - F.D. BAKER



COPY