



SCALE: 1" = 100'


- IRON PIN FOUND
- 5/8" RE BAR WITH I.D. CAP SET
- I.D. CAP MARKED "BAKER 6938"

REFERENCES:

- DEED VOL. 269 PAGE 240
 " " 204 " 636
 " " 207 " 344
 PLAT VOL. 14 PAGE 710
 " " 14 " 705
 " " 14 " 241
 " " 14 " 522

BEARINGS FROM DEED VOL. 267 PAGE 344

MECHANIC TOWNSHIP
 N.E. QTR. SECTION 8
 T-8N R-6W
 HOLMES COUNTY, OHIO

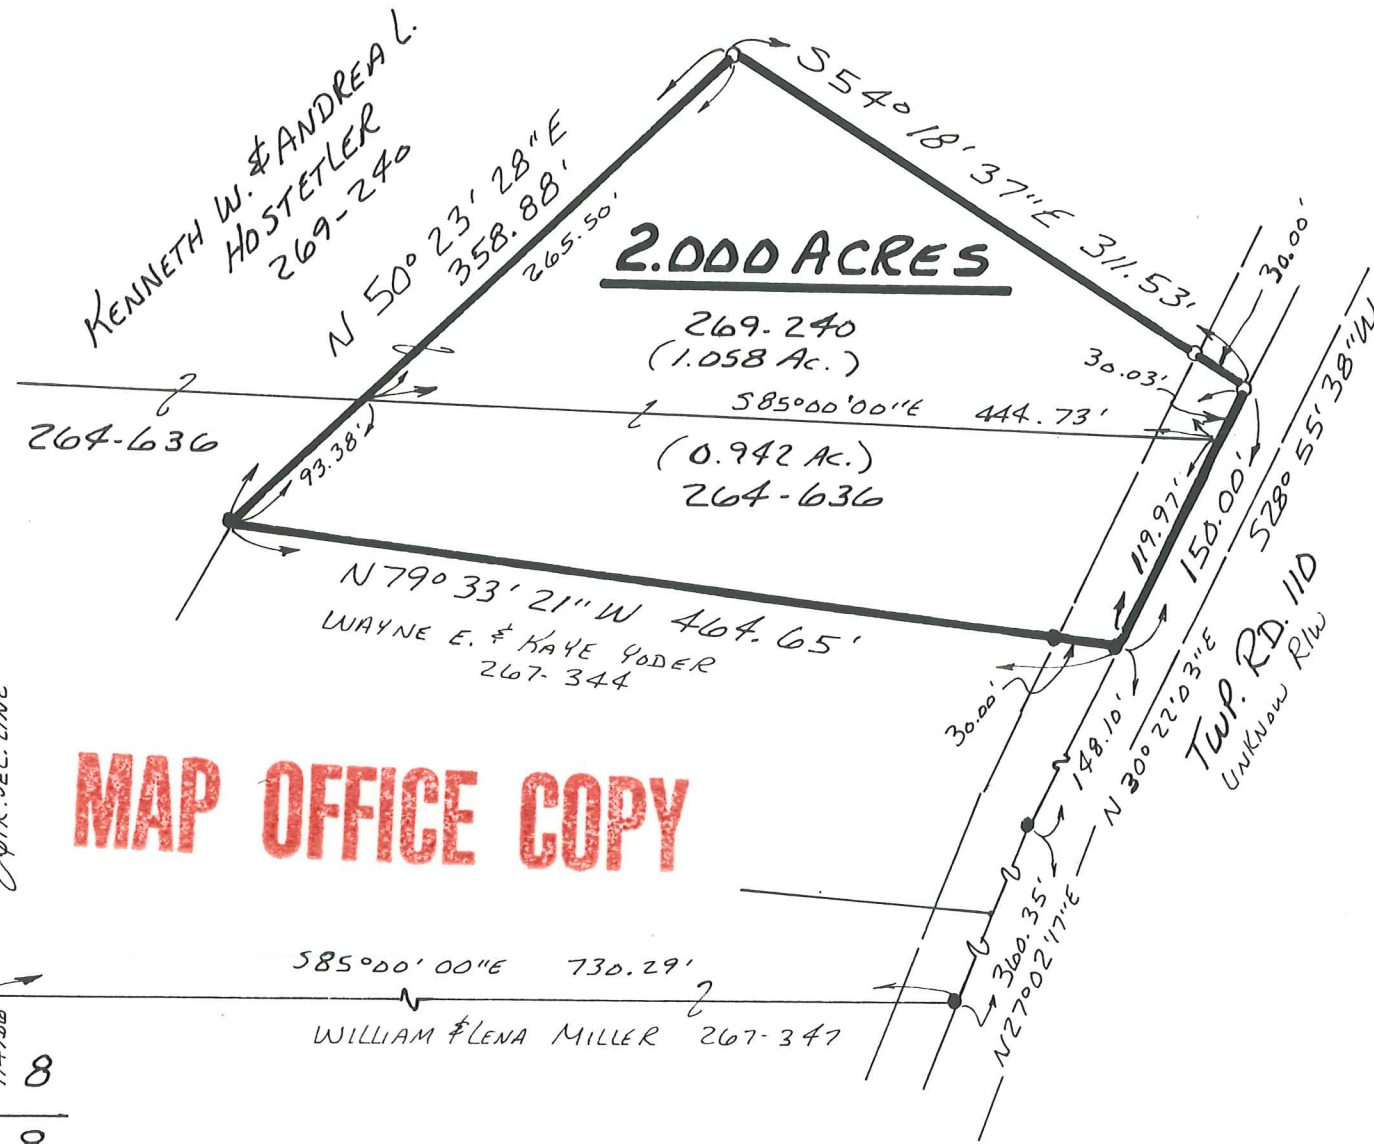

I CERTIFY THIS SURVEY TO BE CORRECT TO THE BEST OF MY KNOWLEDGE.

Donald C. Baker

DONALD C. BAKER P.S. 6938
 5958 T.R. 322
 MILLERSBURG, OHIO 44654
 PH. (216) 674-4788
 NOVEMBER 9, 1995
 60195-MLS

MAP OFFICE COPY



585°00'00"E 730.29'
 WILLIAM & LENA MILLER 267-347