

MECHANIC TOWNSHIP
 S.E. QTR. SECTION 9
 T-8 N ; R-6 W
 HOLMES COUNTY, OHIO

PROPERTY LINE SURVEY
 (STAKED PROPERTY LINE SHOWN BOLDLY.)




SCALE: 1" = 400'

- STONE FOUND
- IRON PIN FOUND
- 5/8" RE BAR WITH I.D. CAP SET I.D. CAP MARKED "BAKER 6938"

REFERENCES:


- DEED Vol. 188 PAGE 283
- DEED Vol. 231 PAGE 137
- PLAT Vol. 10 PAGE 221

BEARINGS ASSUMED

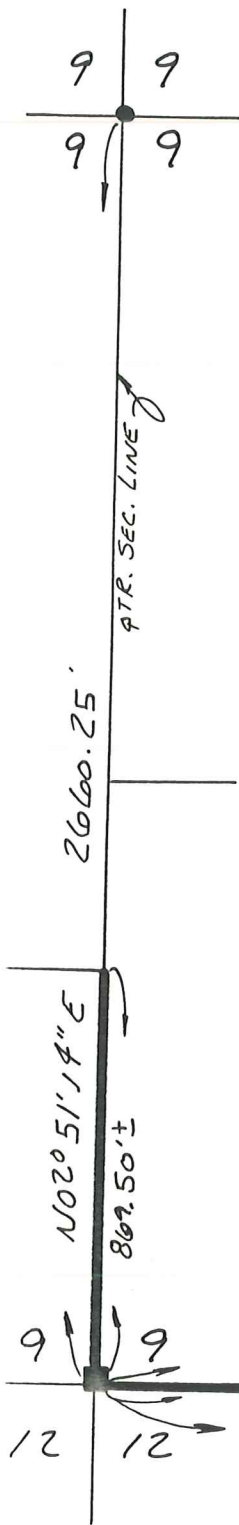

MAP OFFICE COPY

ELI D. SEVILLA MILLER
 176-463 188-283

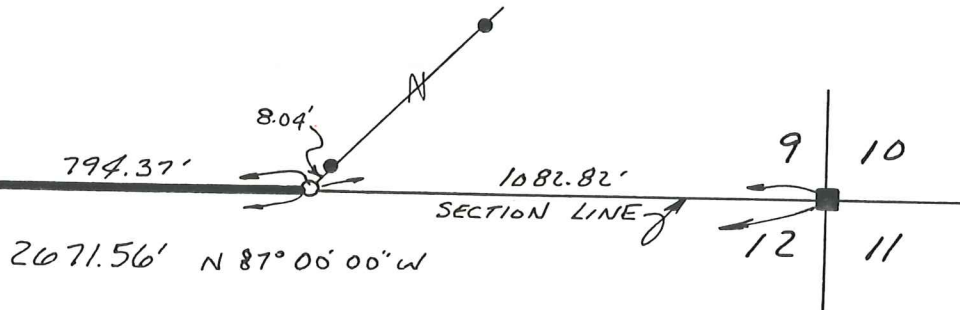

I CERTIFY THIS SURVEY TO BE CORRECT TO THE BEST OF MY KNOWLEDGE.

Donald C. Baker
 DONALD C. BAKER P.S. 6938
 5958 T.R. 322
 MILLERSBURG, OHIO 44654
 PH. (216) 674-4788
 SEPTEMBER 29, 1994

51694-MLS