

NOTE:



IRON PIN FOUND 1.5' SW  
FROM STONE.

MECHANIC TOWNSHIP

SECTION 10

T-8 ; R-6

HOLMES COUNTY, OHIO

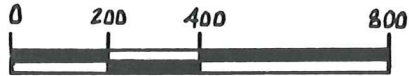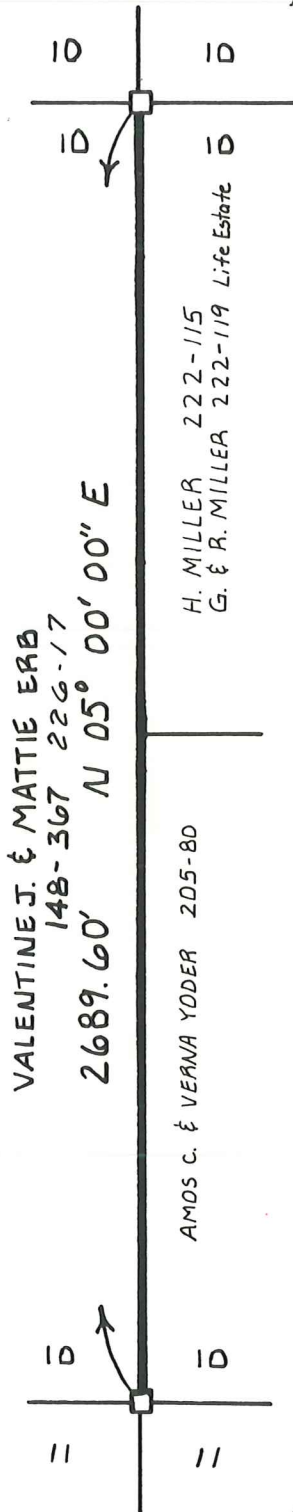

SCALE: 1" = 400'

- STONE FOUND
- STAKES SET ON LINE

BEARINGS ASSUMED

**MAP OFFICE COPY**

I CERTIFY THIS SURVEY TO BE CORRECT  
TO THE BEST OF MY KNOWLEDGE.

Donald C. Baker

DONALD C. BAKER P.S. 6938

5958 TR 322 PH (216) 674-4788

MILLERSBURG, OHIO 44654

JANUARY 13, 1992

