


MECHANIC TOWNSHIP  
 N.W. & S.W. QTRS. SEC. 11  
 T-BN 1R. 6W  
 HOLMES COUNTY, OHIO

PROPERTY LINE SURVEY

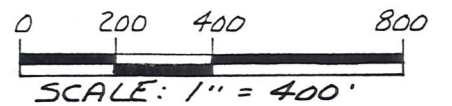


- STONE FOUND
- ▲ R.R. SPIKE FOUND
- P.K. NAIL FOUND
- IRON PIN FOUND
- 5/8" RE BAR WITH I.D. CAP SET
- I.D. CAP MARKED "BAKER 6938"
- STAKES SET ON LINE
- CORNER POST FOUND

REFERENCES:

DEED VOL. 226 PAGE 17  
 DEED VOL. 157 PAGE 558  
 DEED VOL. 176 PAGE 771  
 DEED VOL. 240 PAGE 411  
 PLAT VOL. 10 PAGE 366

BEARINGS FROM  
 PLAT VOL. 12 PAGE 71

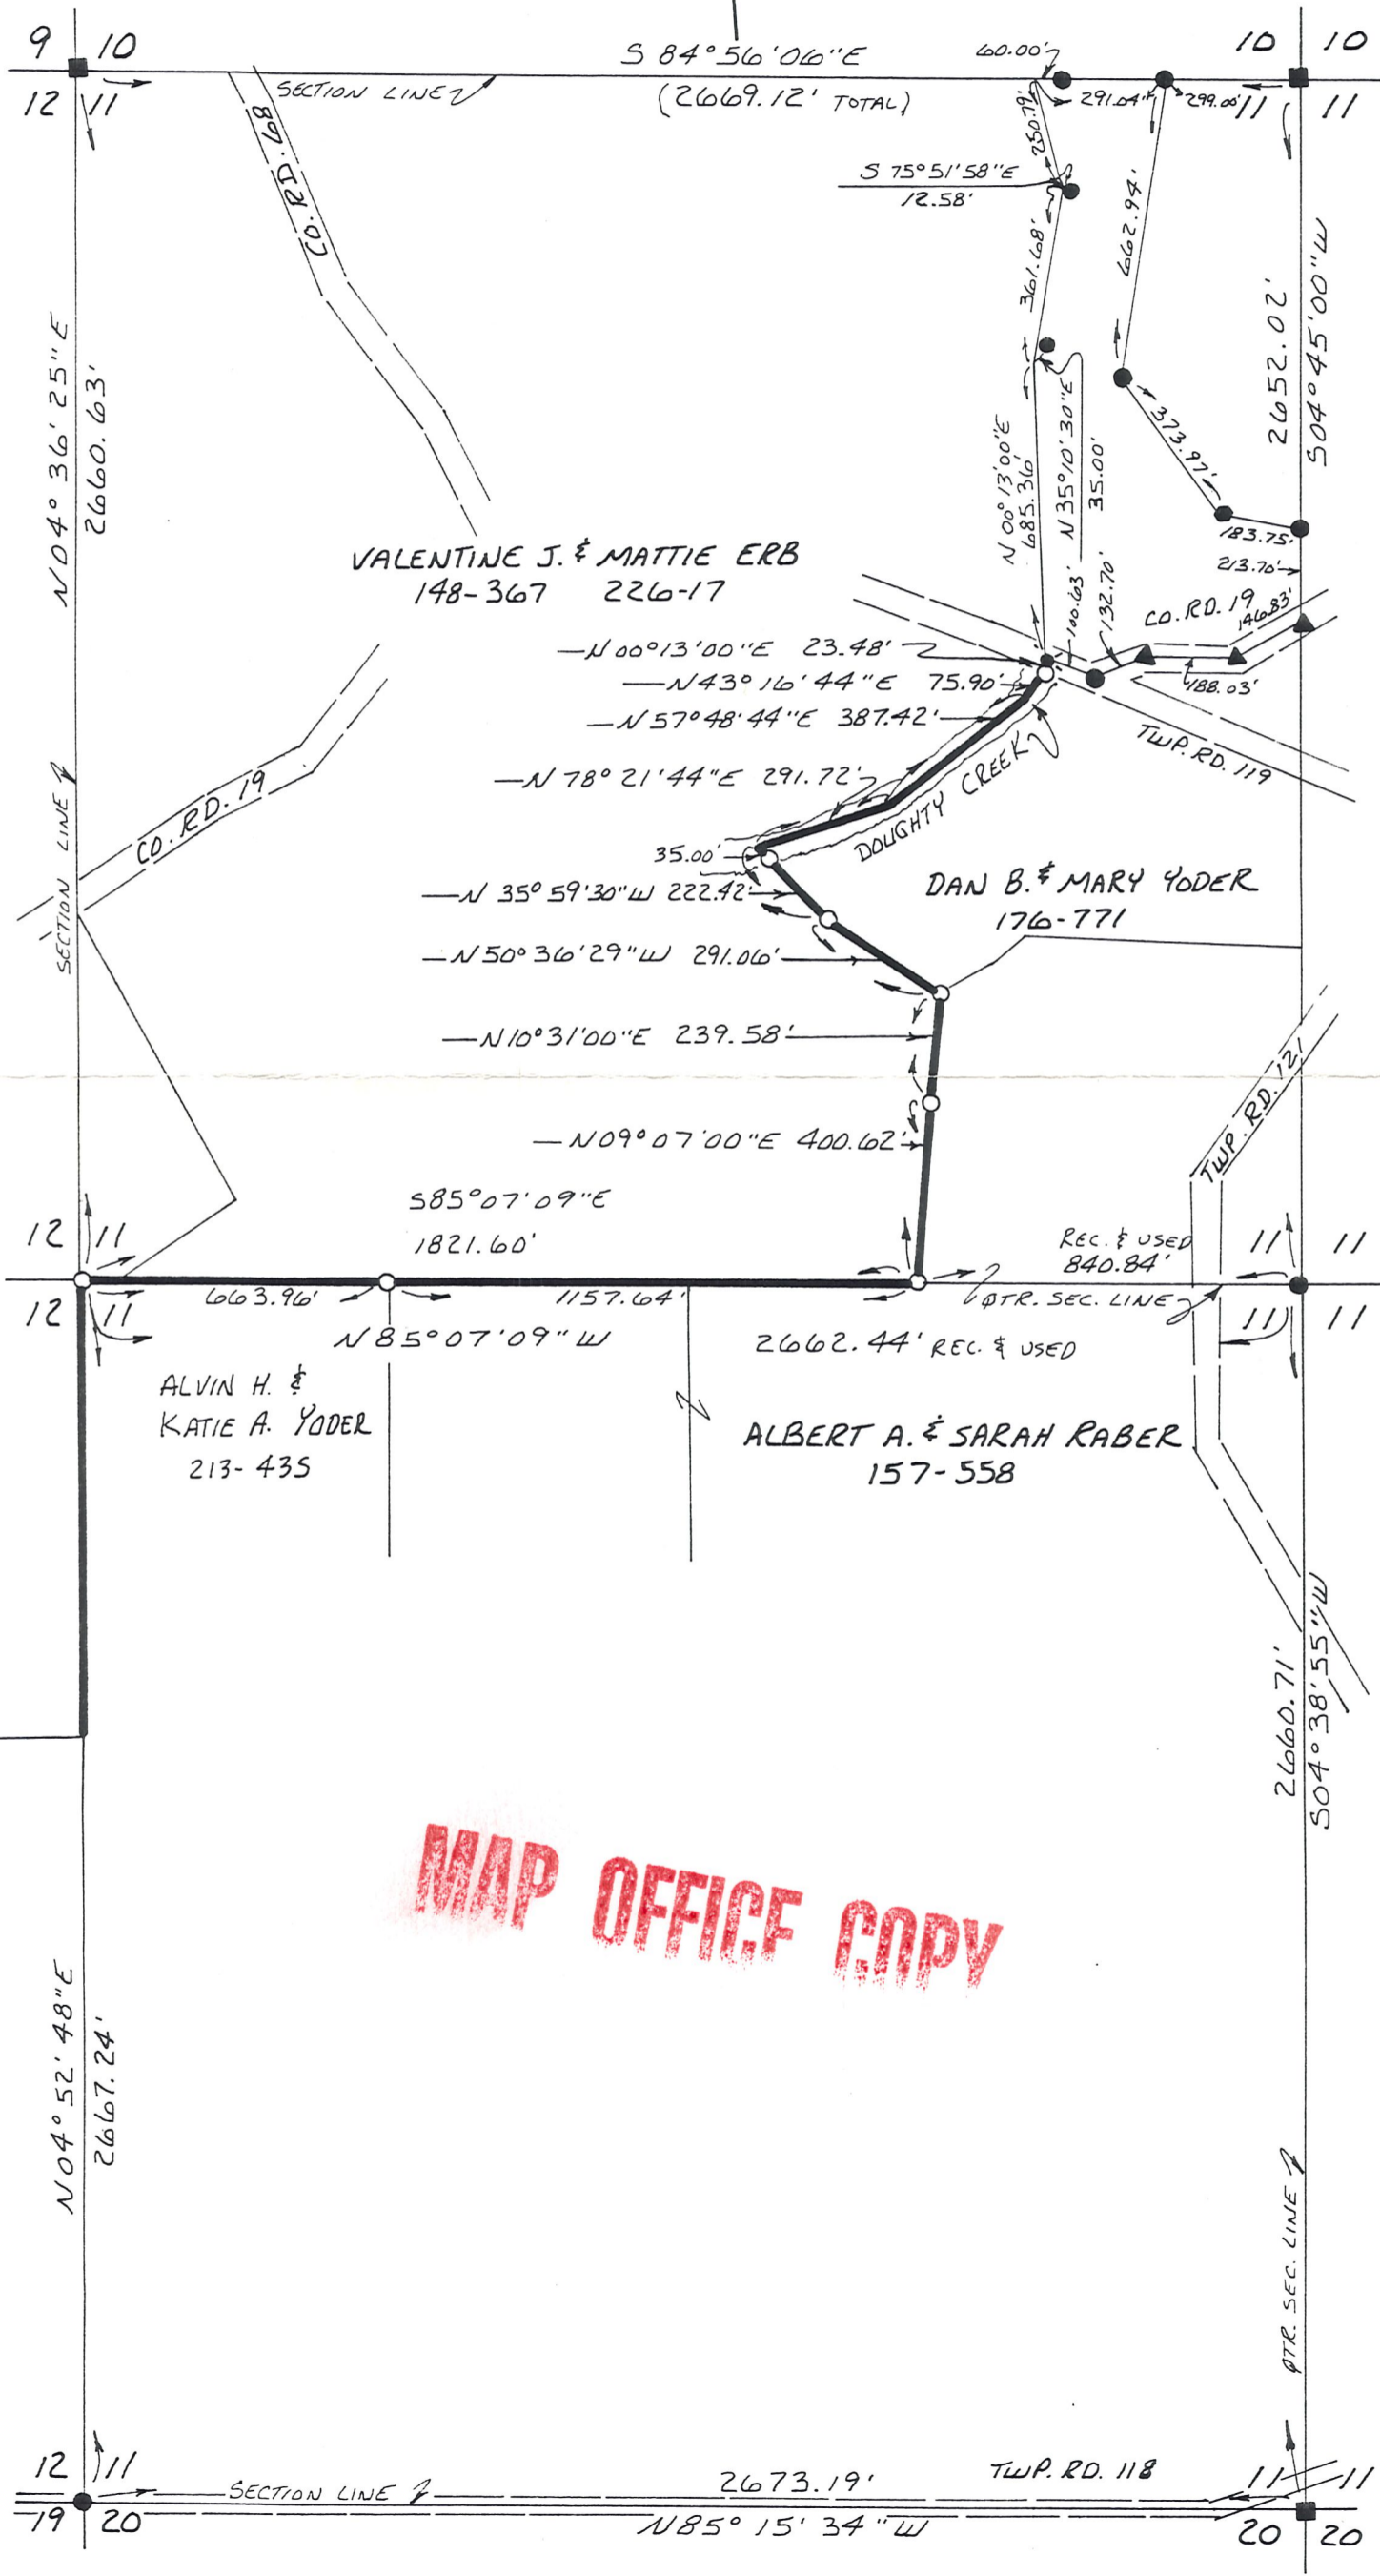

MAP OFFICE COPY

I CERTIFY THIS SURVEY TO  
 BE CORRECT TO THE BEST  
 OF MY KNOWLEDGE.

*Donald C. Baker*  
 DONALD C. BAKER P.S. 6938  
 5958 TWP. RD. 322  
 MILLERSBURG, OHIO 44654  
 PH. (216) 674-4788

JANUARY 31, 1992

1792-MLS