


HEARTLAND Surveying

Jim Shamp
 5210 Twp. Rd. 257 Millersburg, OH 44654
 Phone: 216-674-4698

SURVEY		DATE	
FDIC		NOVEMBER 4, 1993	
STATE	COUNTY	TOWNSHIP	RANGE
OHIO	HOLMES	MECHANIC	7 WEST
TOWNSHIP	SECTION		CRD
8 NORTH	10		9311001.CRD



I CERTIFY THIS TO BE A TRUE PLAT OF A FIELD SURVEY COMPLETED ON NOVEMBER 3, 1993:

JIM SHAMP, REG. SUR. NO. S-6088

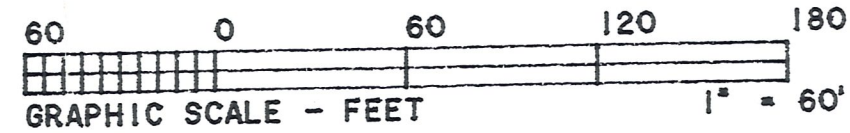

LEGEND:
 O = I.P. FOUND


REFERENCE DOCUMENTS:
 TAX MAP
 SURVEY PLAT V. 8, P. 583
 DEEDS AS SHOWN

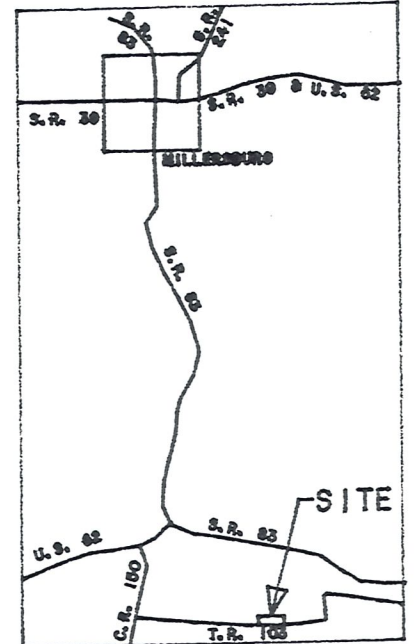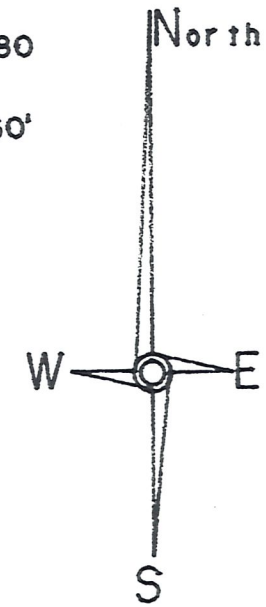

LOCATION MAP
 NO SCALE

HORACE A. & MARTHA M. DUTTON
 V. 157, P. 96

* BEARINGS ESTABLISHED FROM PLAT V. 8, P. 583

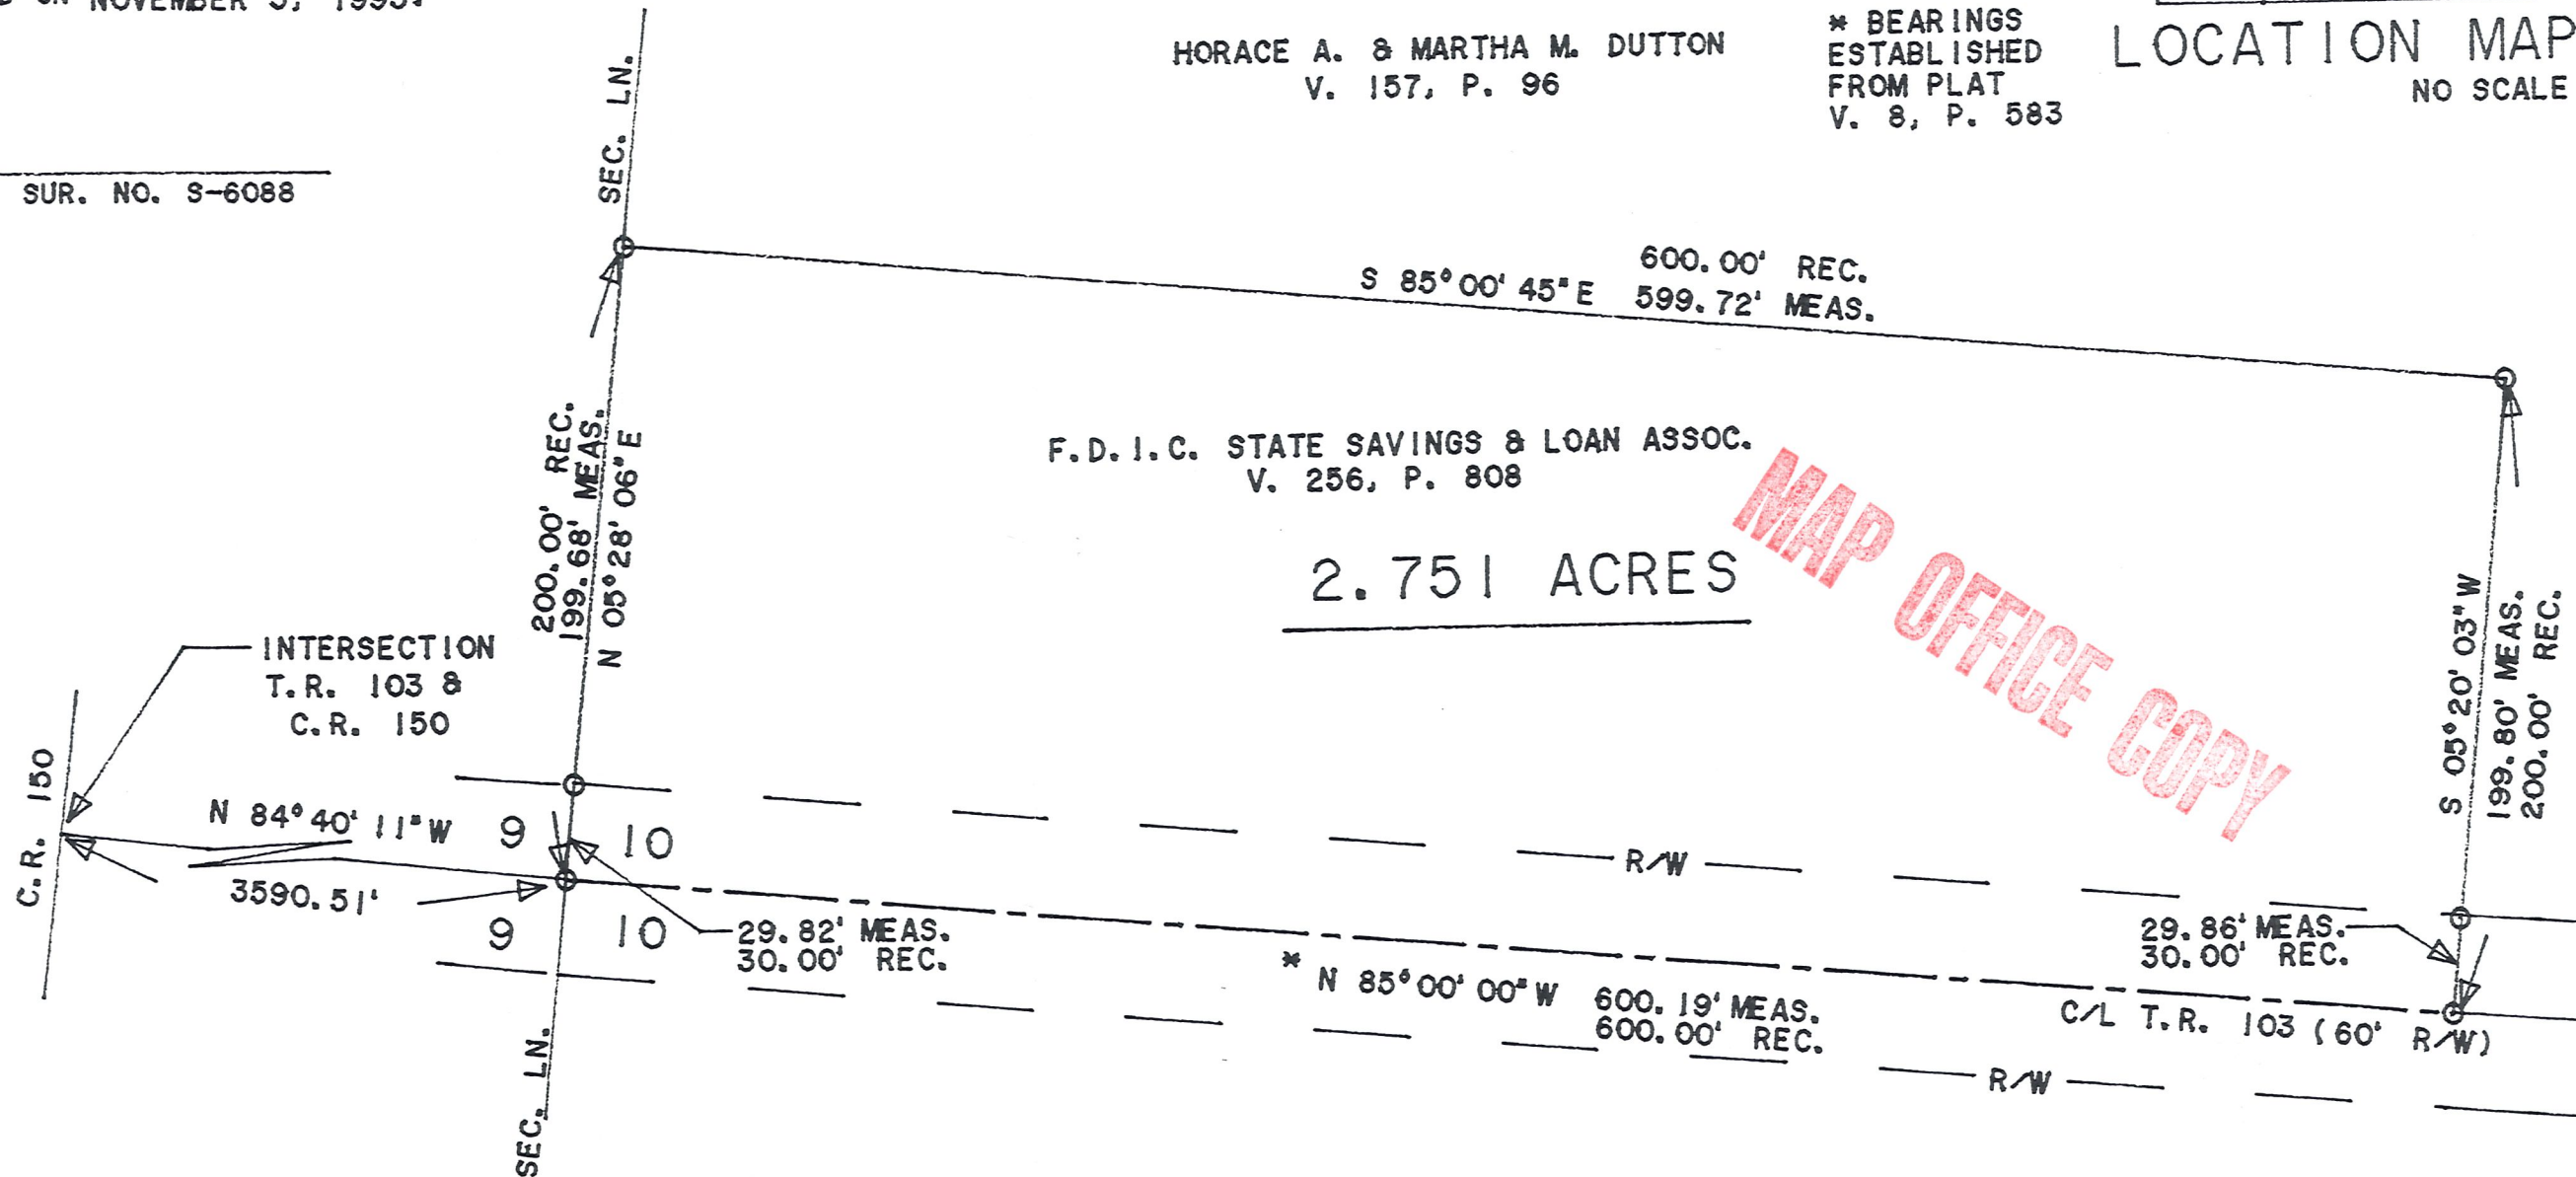

F.D.I.C. STATE SAVINGS & LOAN ASSOC.
 V. 256, P. 808

2.751 ACRES

MAP OFFICE COPY