


Mechanic Township
S.E. Qtr. Sec. 21
T-8 N; R-7 W
Holmes County, Ohio

SURVEYED FOR: Kiko Auctions

Deed as shown

Plat Vol. 13 Page 141
Plat Vol. 15 Page 007
Plat Vol. 15 Page 118

Basis of Bearing:
Grid North, Ohio State Plane Coordinate
System, North Zone, NAD 83
(2011). Distances shown hereon are ground
distances. To obtain grid distances multiply
distances by scale factor of 0.9999650451.

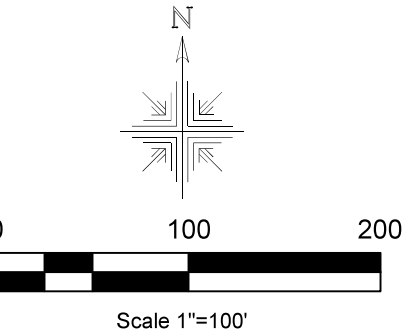



- ◊ P.K. Nail Found
- Stone Found
- 5/8" Rebar Found
- ⦿ 5/8" Capped Pin Found "Baker"
- 5/8" Capped Pin Set "Galbraith-8703"
- ▲ R.R. Spk. Found
- Point

Pioneer Surveying & Services, LLC.
5434 Township Road 377
Millersburg, Ohio 44654
Phone: 330-231-0497
Email: caleb@pioneersurveyingandservices.com



I certify this survey to be correct to the best of
my knowledge.

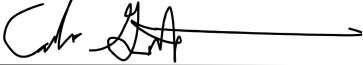
Caleb Jerome Galbraith P.S. 8703
Date: Jan. 5, 2026
Job ID: 27325

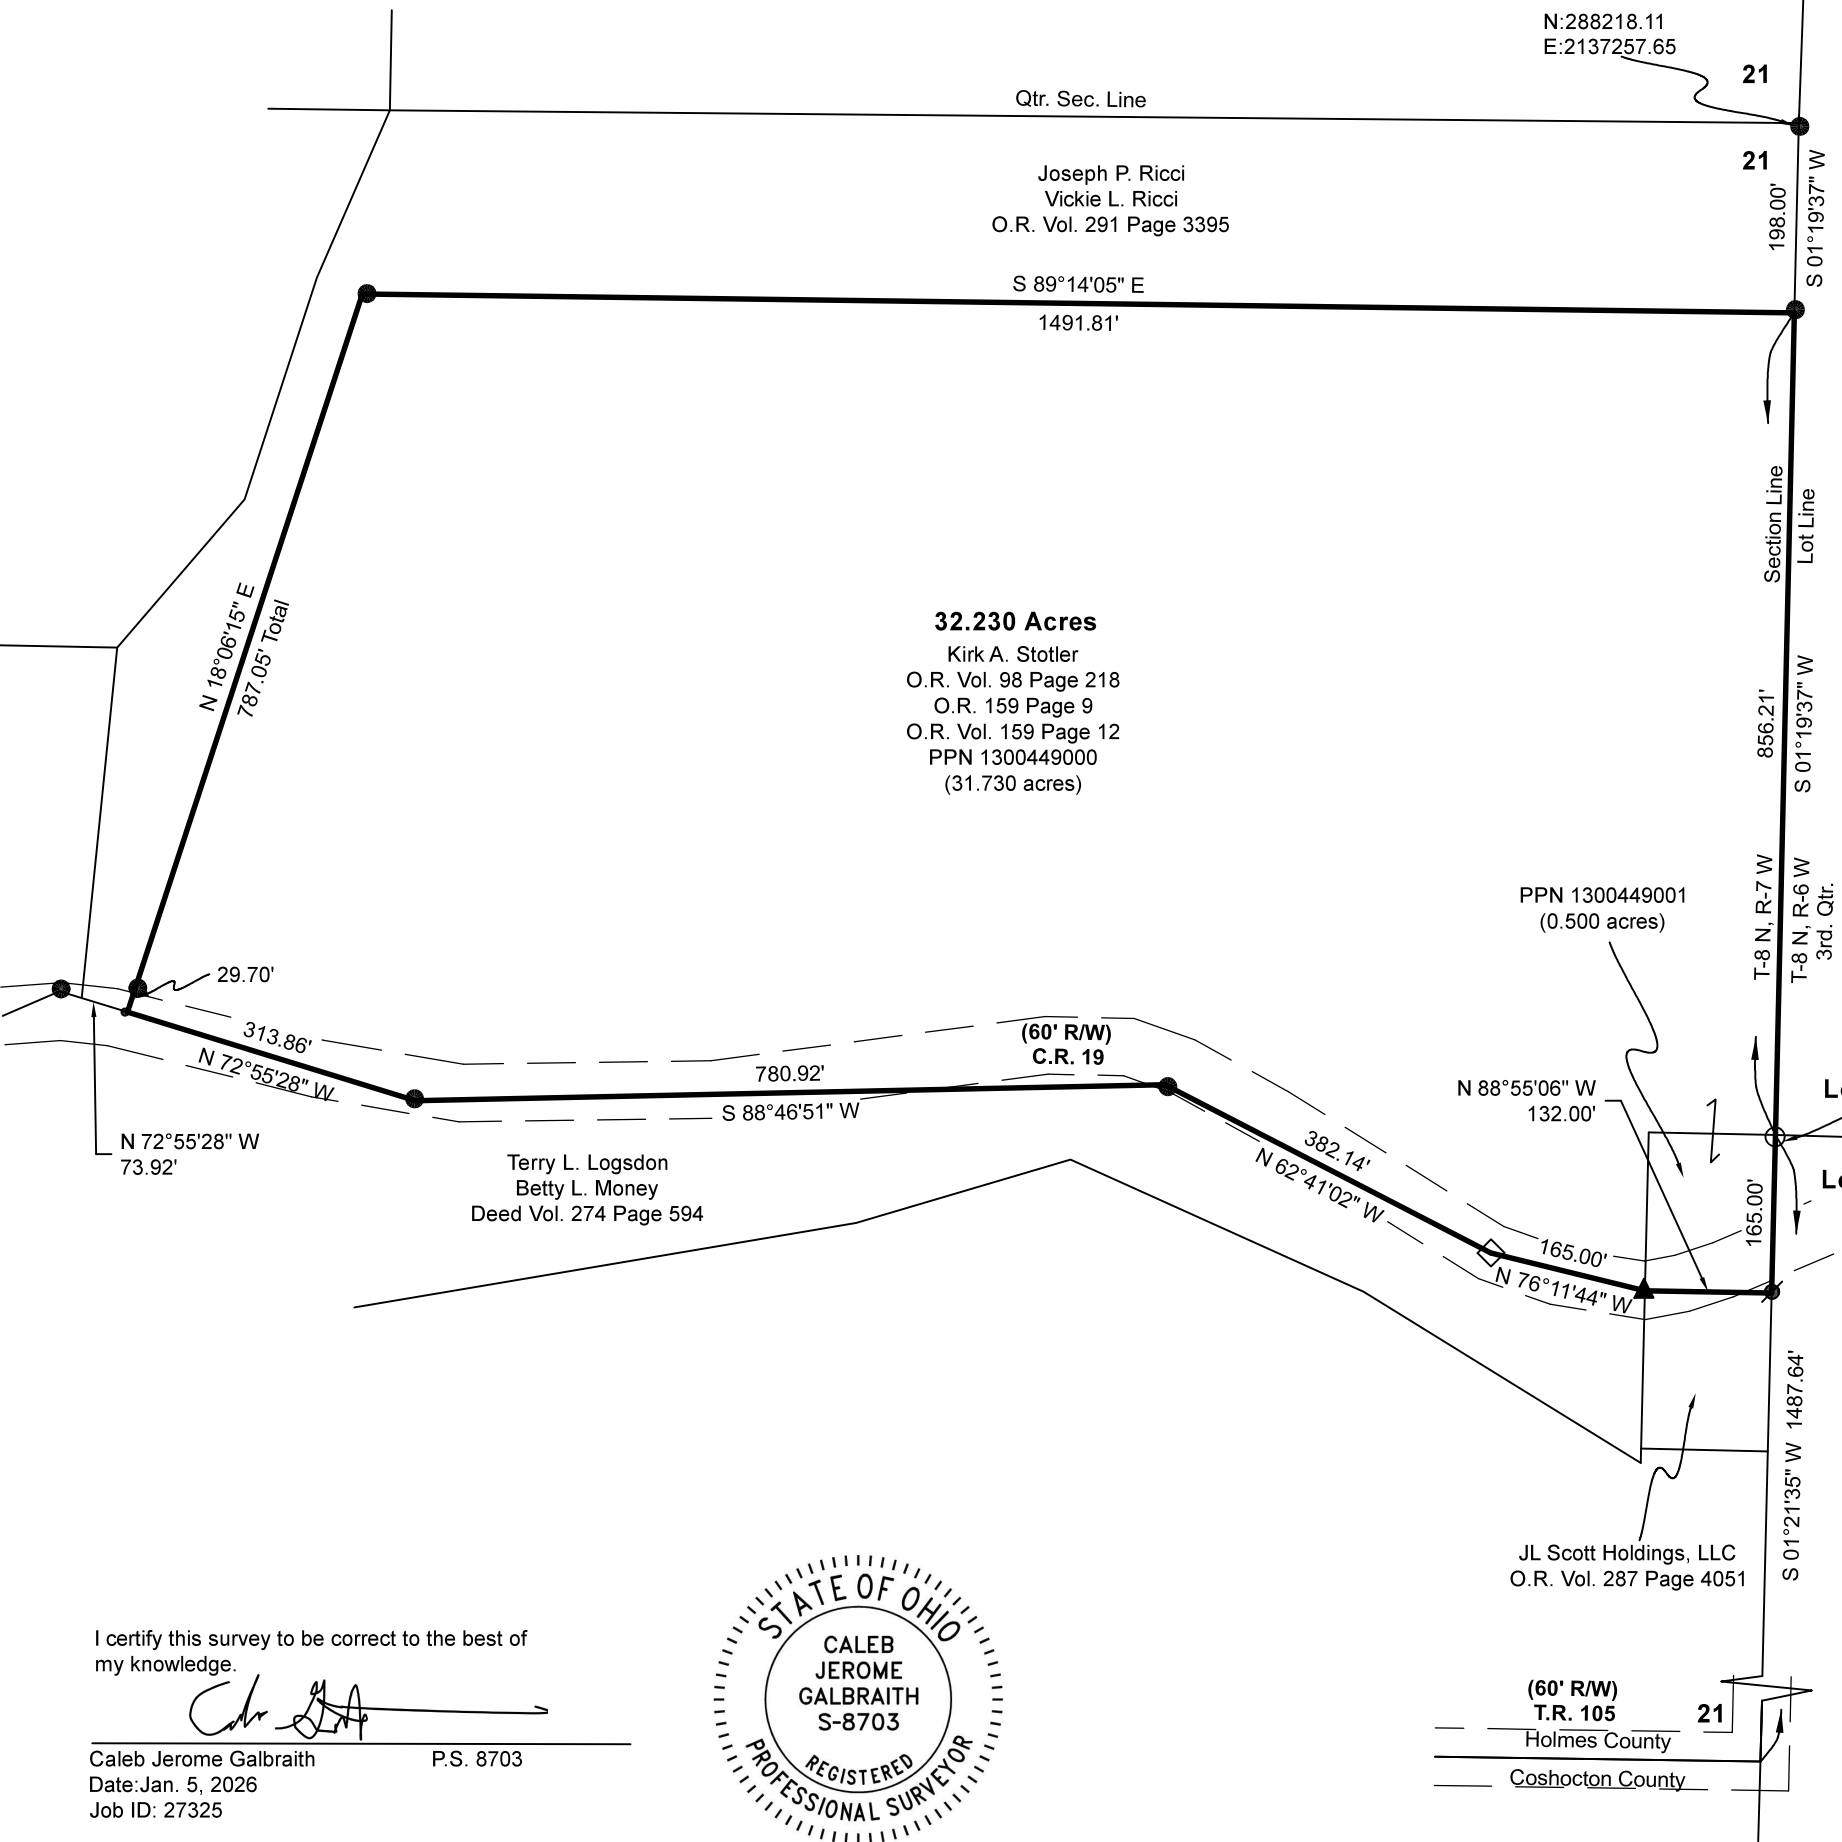

(60' R/W)
T.R. 105
Holmes County
Coshocton County