MONROE TOWNSHIP
WEST HALF SECTION 21
T-17N; R-14W
HOLMES COUNTY, OHIO

REFERENCES:

DEED VOL. 249 PG. 775	SURVEY RECORD 4 PG. 100
DEED VOL. 176 PG. 25	SURVEY RECORD 5 PG. 133
DEED VOL. 200 PG. 21	SURVEY PLAT VOL. 8 PG. 874
DEED VOL. 169 PG. 379	SURVEY PLAT VOL. 8 PG. 532
DEED VOL. 126 PG. 502	SURVEY PLAT VOL. 13 PG. 6
DEED VOL. 13 PG. 528	

(SURVEYED FOR: LARRY LANG)

0 50 100 150 200

Scale 1" = 100'

LEGEND:

- IRON PIN FOUND
- R.R. SPK. SET
- P.K. NAIL W/ SHINER SET
- 5/8" REBAR WITH I.D. CAP SET I.D. CAP MARKED "BAKER 6938"
- R RECORD DISTANCE
- M MEASURED DISTANCE

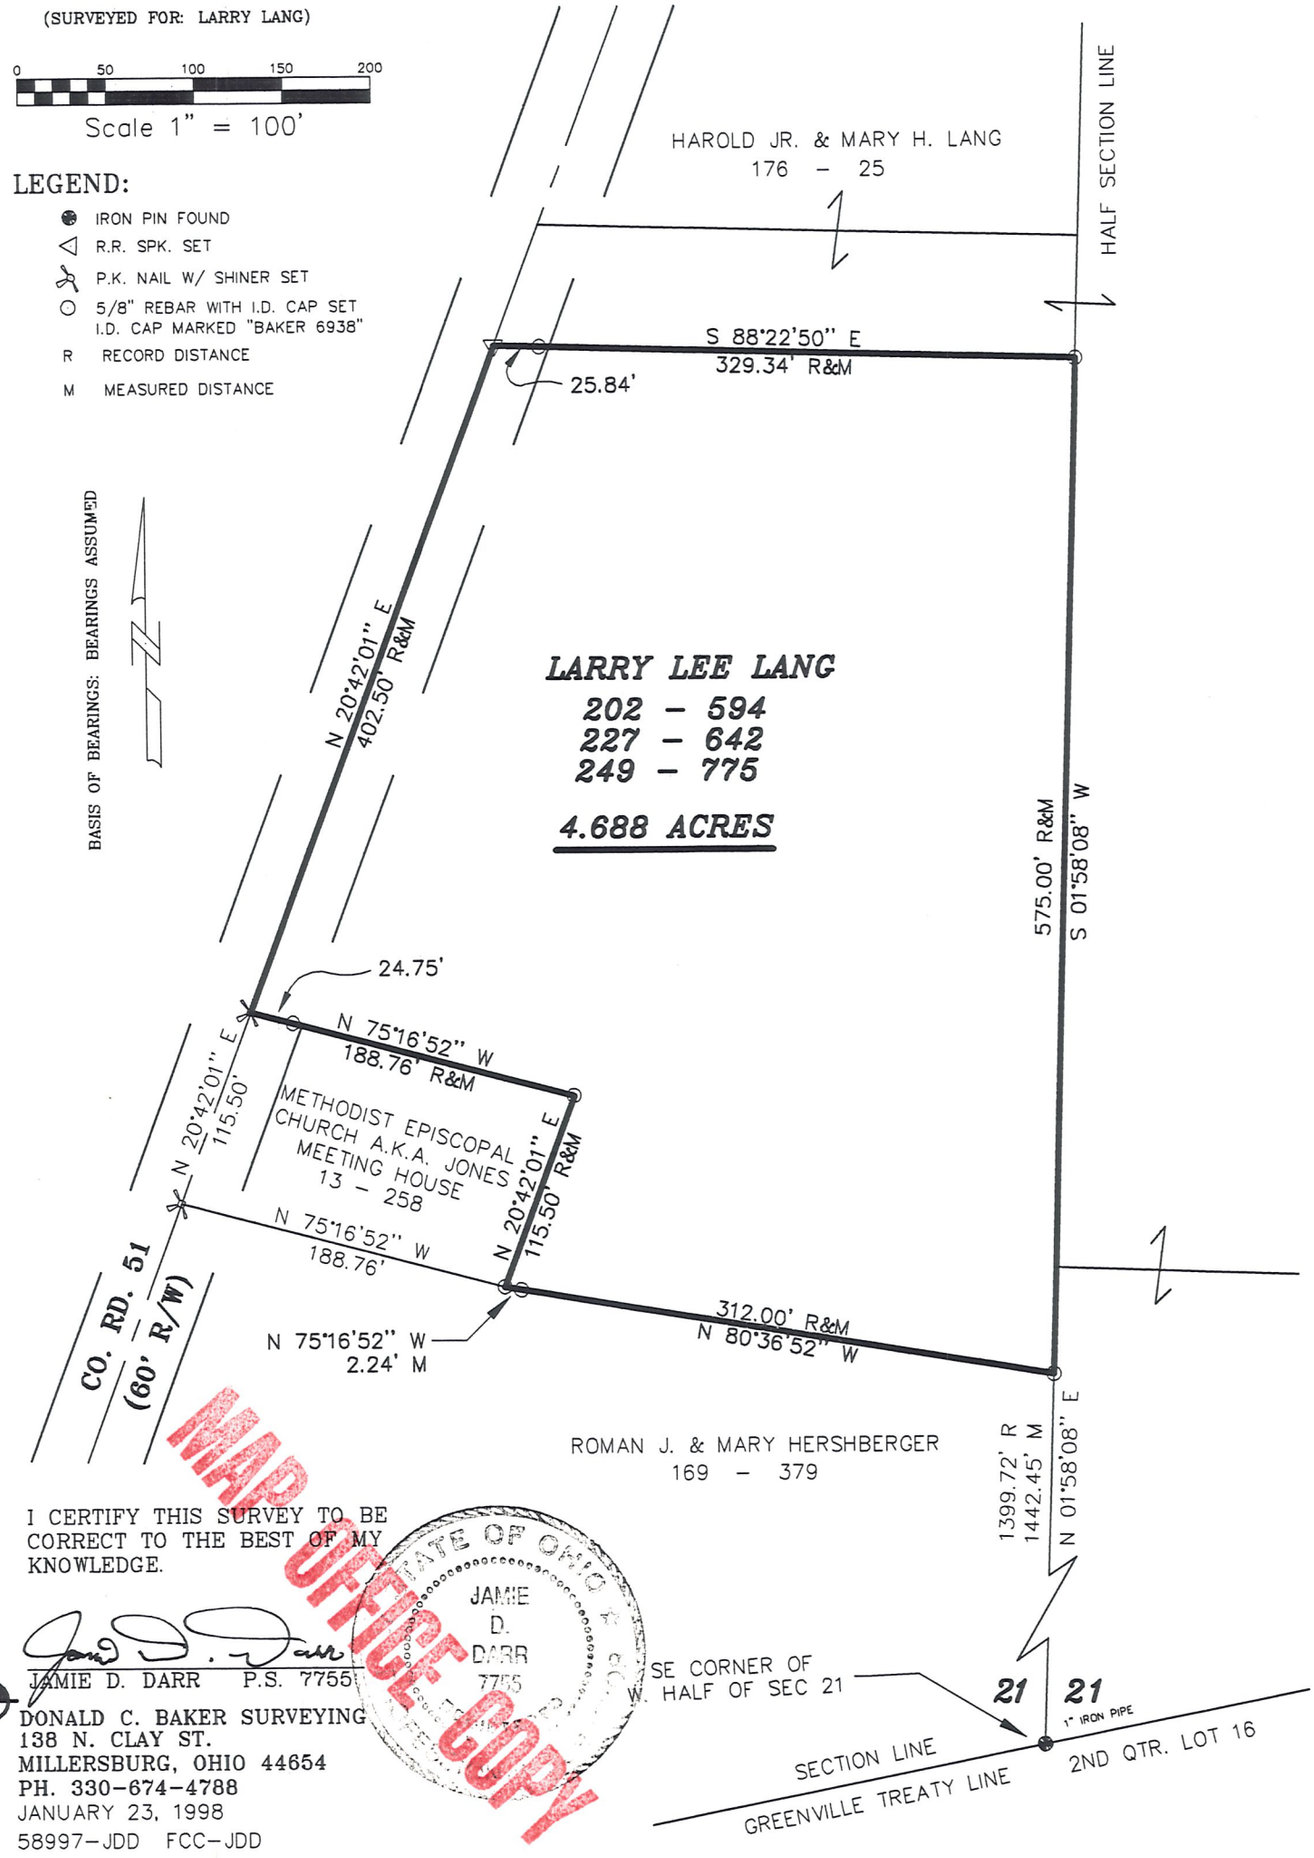

I CERTIFY THIS SURVEY TO BE CORRECT TO THE BEST OF MY KNOWLEDGE.

JAMIE D. DARR P.S. 7755

STATE OF OHIO JAMIE D. DARR 7755 REGISTERED SURVEYOR

MAP OFFICE COPY

DONALD C. BAKER SURVEYING
138 N. CLAY ST.
MILLERSBURG, OHIO 44654
PH. 330-674-4788

JANUARY 23, 1998

58997-JDD FCC-JDD