

MONROE TOWNSHIP

FRACTIONAL SECTION 23
T-17N; R-14W
HOLMES COUNTY, OHIO





- SCALE: 1" = 500'
- IRON PIN FOUND
 - 5/8" REBAR WITH ID CAP SET
ID CAP MARKED "BAKER 6938"
 - △ R.R. SPIKE SET

REFERENCES

DEED VOL. 265	PAGE 842
DEED VOL. 265	PAGE 431
DEED VOL. 270	PAGE 252
DEED VOL. 270	PAGE 607
DEED VOL. 270	PAGE 877
DEED VOL. 222	PAGE 882
PIAT VOL. 15	PAGE 35
PIAT VOL. 14	PAGE 919
PIAT VOL. 14	PAGE 940
PIAT VOL. 12	PAGE 241

BEARINGS FROM DEED VOL. 270 PAGE 252

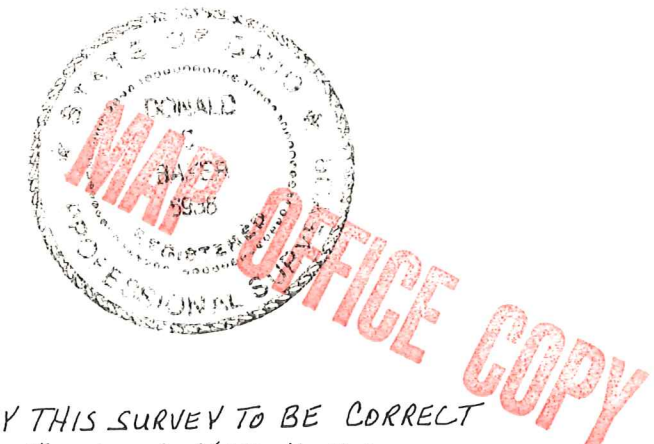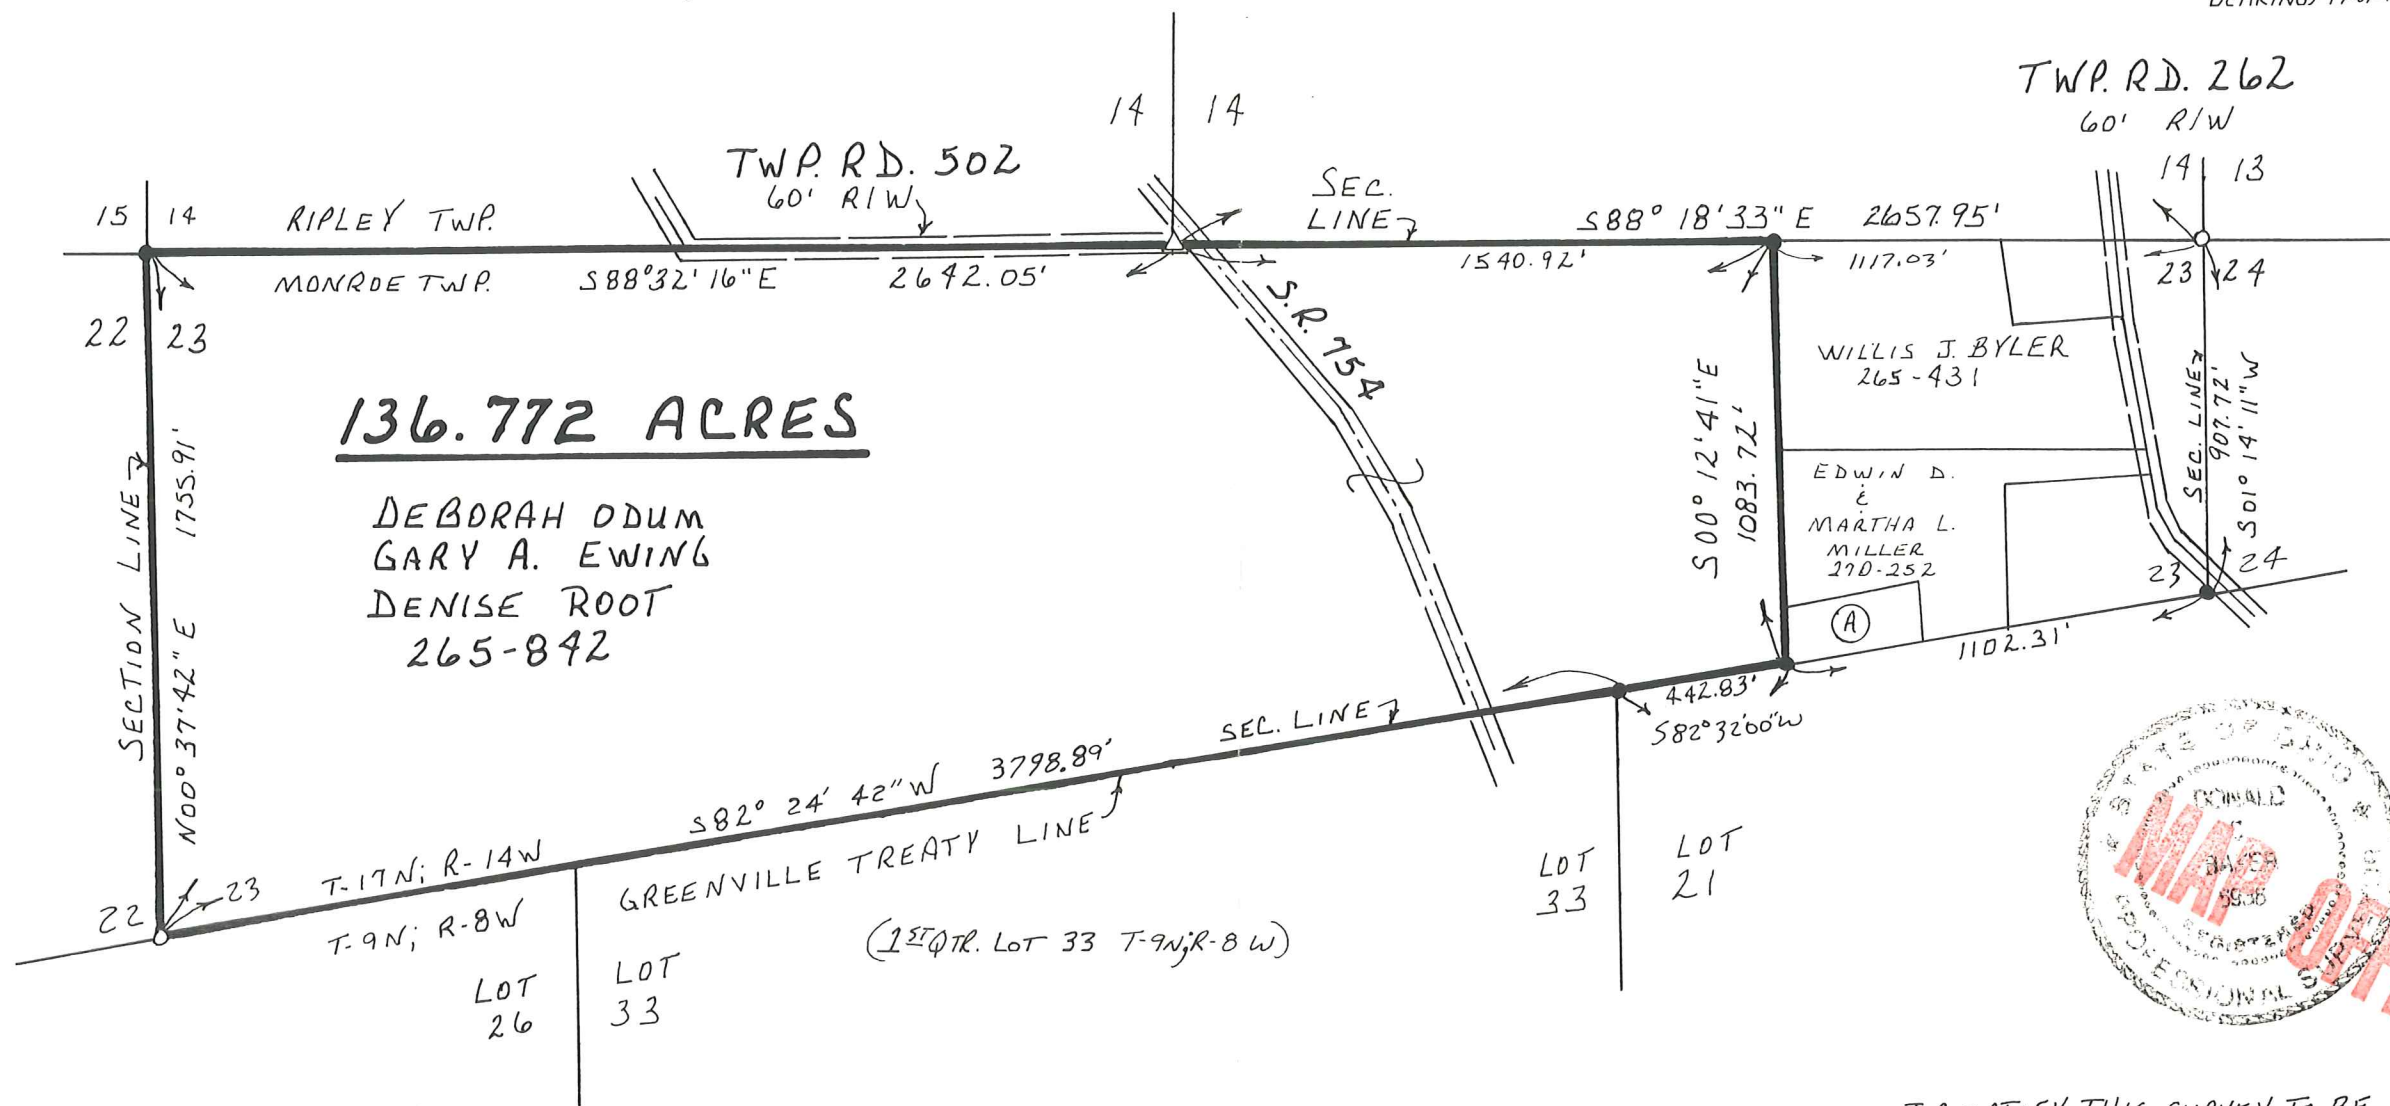

(A) ROBERT G. & JUDY L. MILLER
270-607

I CERTIFY THIS SURVEY TO BE CORRECT
TO THE BEST OF MY KNOWLEDGE.

Donald C. Baker
DONALD C. BAKER P.S. 6938
5958 T.R. 322
MILLERSBURG, OHIO 44654
PH. (330) 674-4788

APRIL 5, 1996

12496-SRU