



SCALE: 1" = 100'


- STONE FOUND
- IRON PIN FOUND
- 5/8" Re BAR WITH I.D. CAP SET  
I.D. CAP MARKED "BAKER 6938"

MONROE TOWNSHIP  
1ST. QTR. LOT 11  
T-9N; R-8W  
HOLMES COUNTY, OHIO  
(SURVEYED FOR: LARRY LODER)

REFERENCES:

DEED VOL. 224 PAGE 44  
" " 192 " 515  
" " 171 " 236

BEARINGS FROM PLAT VOL. 7 PAGE 543

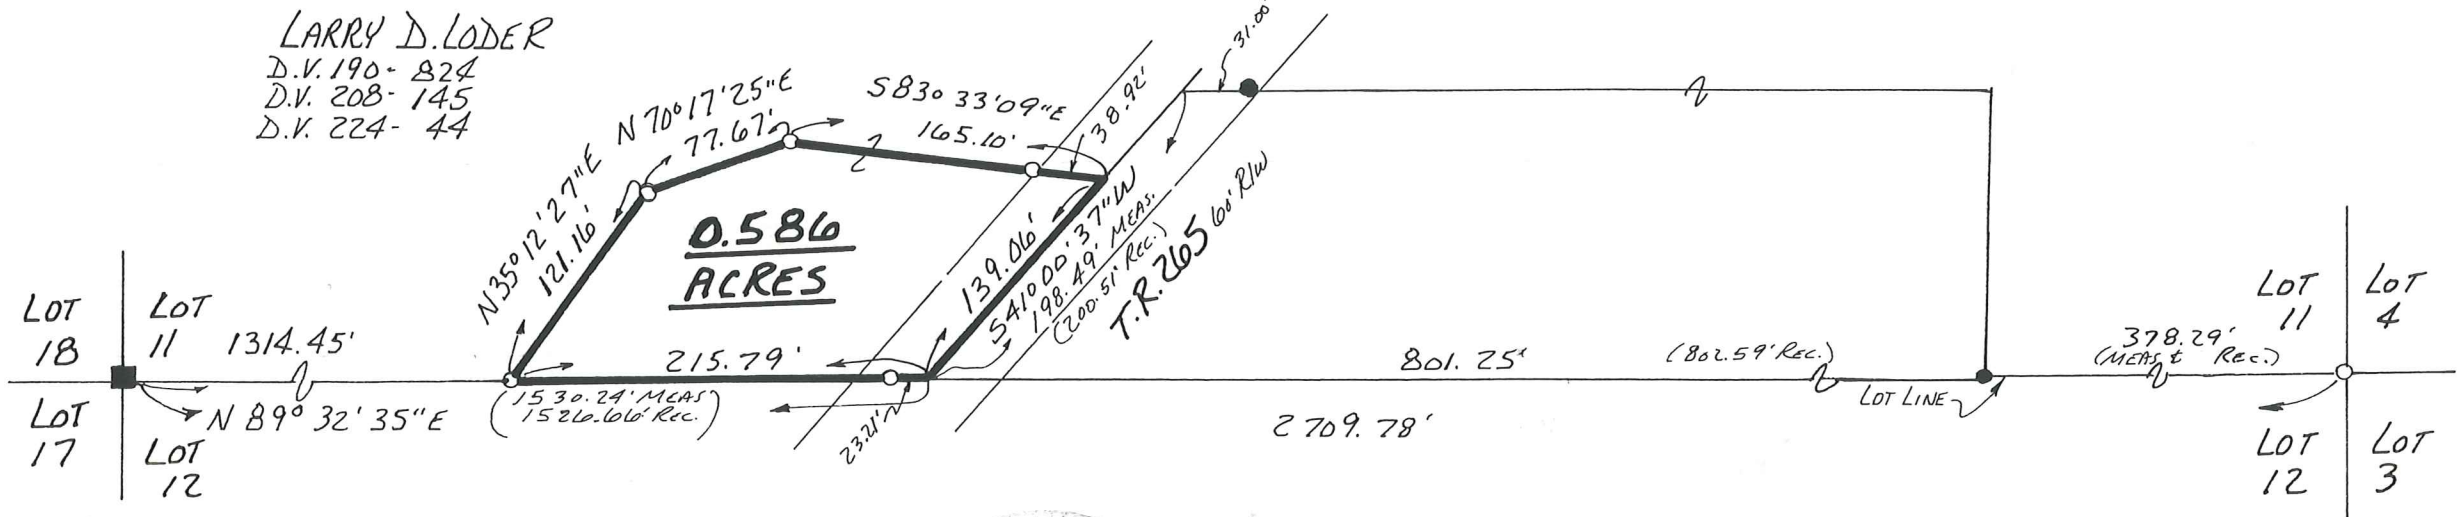

LARRY D. LODER  
D.V. 190-824  
D.V. 208-145  
D.V. 224-44

0.586  
ACRES

I CERTIFY THIS SURVEY TO BE CORRECT TO THE BEST OF MY KNOWLEDGE.

*Jamie D. Darr*

JAMIE D. DARR P.S. 7755  
DONALD C. BAKER SURVEYING  
138 N. CLAY ST.  
MILLERSBURG, OH 44654  
PH. 330-674-4788  
FEBRUARY 23, 2001

# 11501 - M.L. DAVIS  
F.C.C. - J.D. DARR



MAK OFFICE COPY