HOL. CO. ENGR. FILE

325

MONROE TOWNSHIP
S.W. COR. LOT 20
TWP. 9 RANGE 8
HOLMES COUNTY OHIO

MADE FOR
RALPH CLINAGE

SCALE 1"=100'
O I.P. SET
● I.P. Fd.

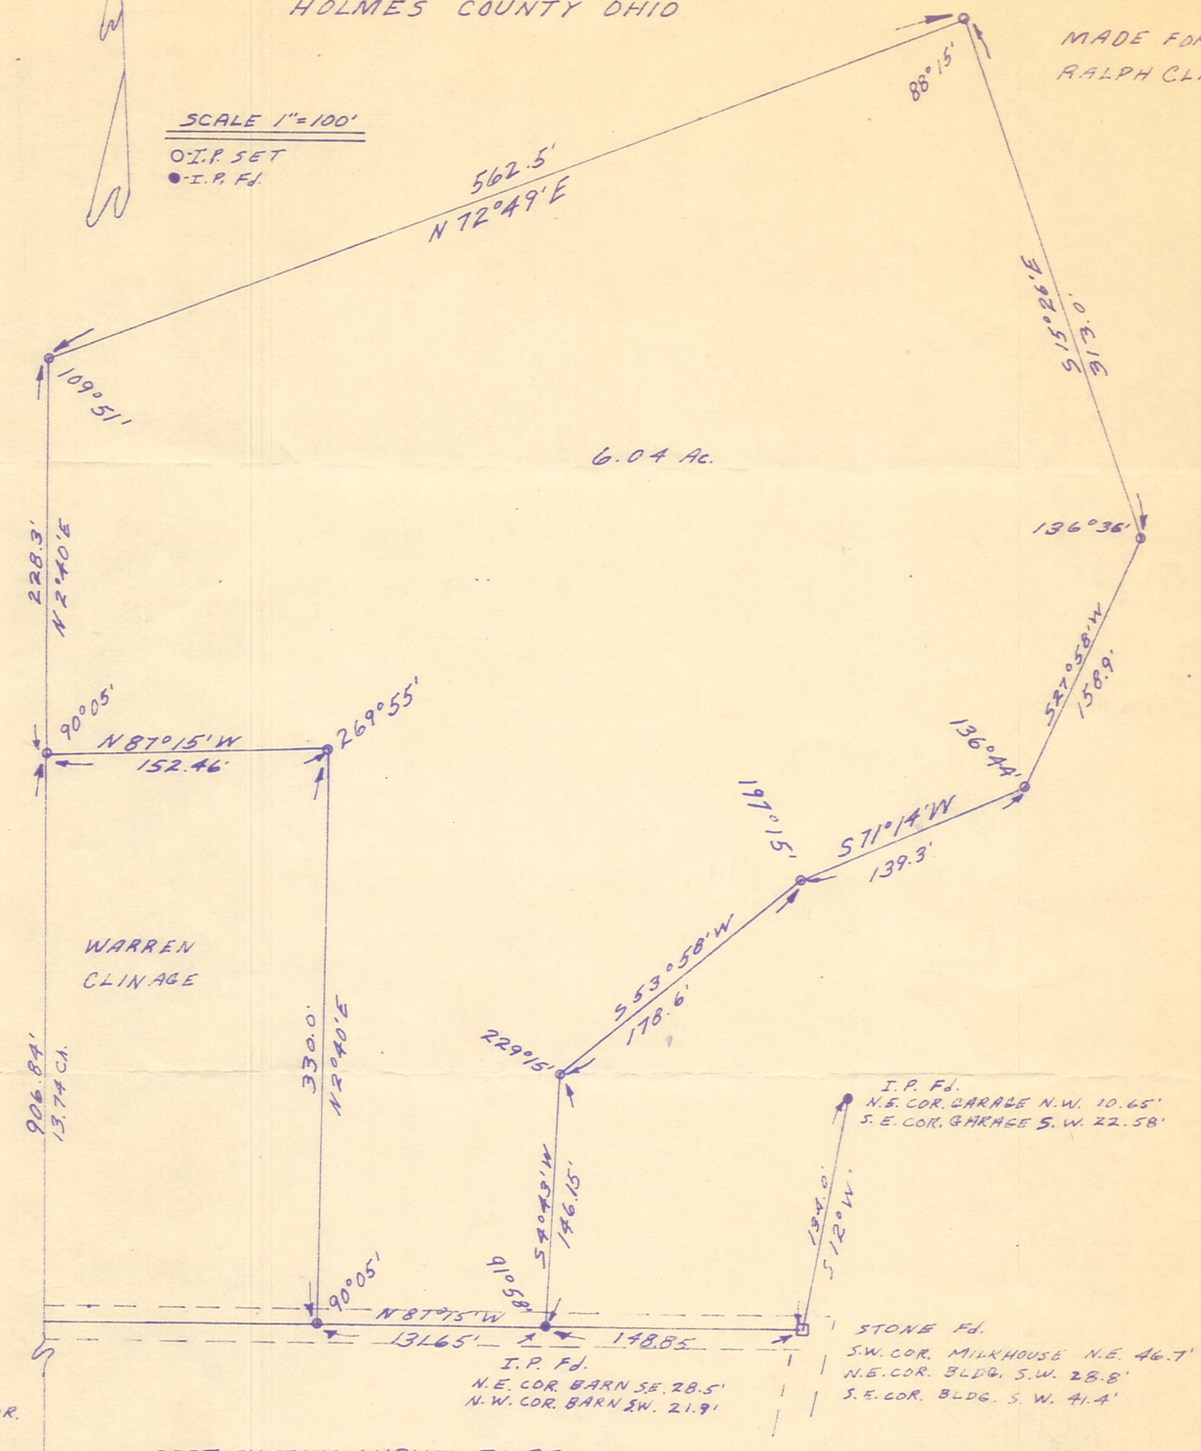

I CERTIFY THIS SURVEY TO BE
CORRECT TO THE BEST OF
MY KNOWLEDGE.
COMPLETED 8-68

James A. Berry

JAMES A. BERRY P.S. 4995
R.W. GRISBARRE & ASSOC.
BOX 44
WOOSTER, OHIO 44691

REF. – DEED VOL. 85 P. 471
124 P. 216
141 P. 233
97 P. 491
SURVEYOR'S VOL. 5 P. 155

MAP OFFICE COPY