
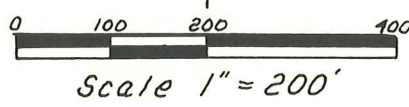


MONROE TOWNSHIP
 HOLMES COUNTY, OHIO
 Lots 10 & 11, 2nd Qtr., T-9N, R-8W

Marilyn J. Brannon
 Deed Vol. 220 Pg. 327

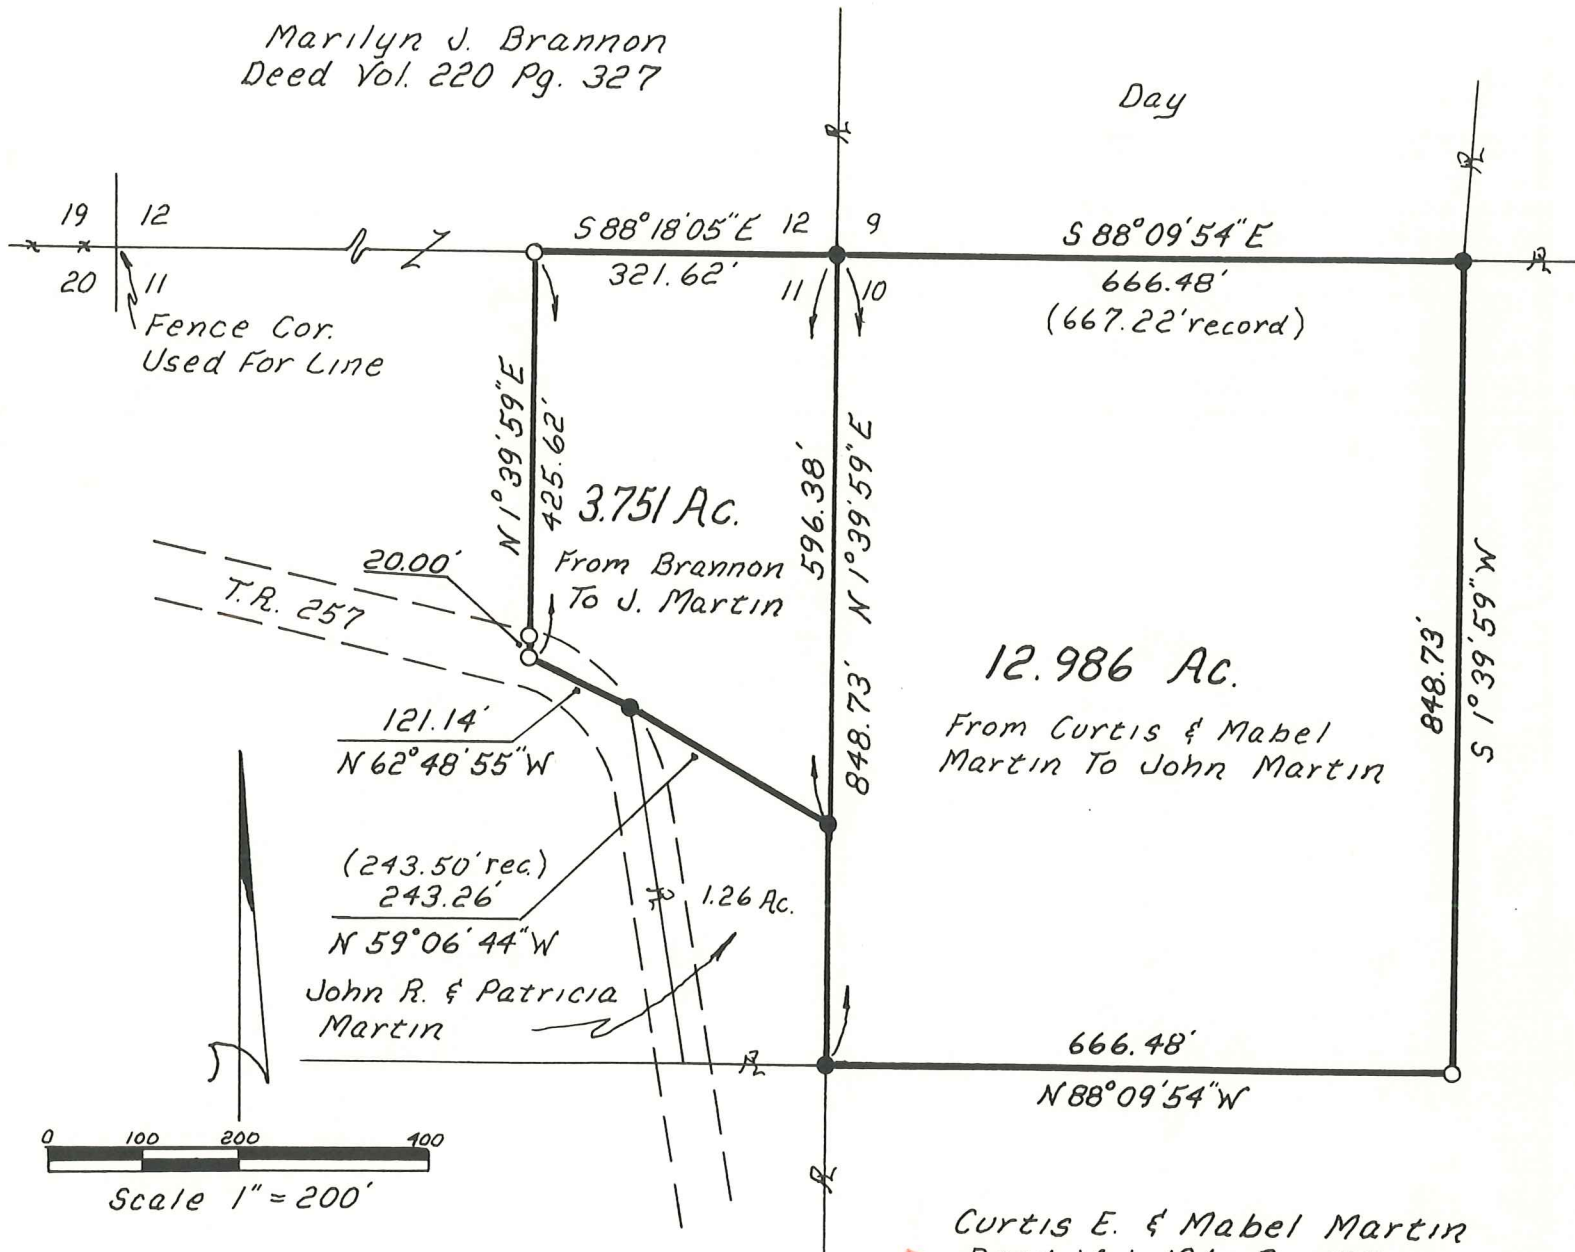

- Iron Pin Found
- Iron Pin Set (5/8" x 30" bar w/cap)

Reference:
 Plat Vol. 7 Pg. 229
 27 Ac. Survey By Gute For Day
 Bearings Assumed

Curtis E. & Mabel Martin
 Deed Vol. 126 Pg. 183

MAP OFFICE

STATE OF OHIO

I Certify This Plat To Be Correct
 To The Best Of My Knowledge

William H. Long Aug 31 1983

William H. Long R.S. 6505

SURVEYOR