


MONROE TOWNSHIP
 2ND. QTR., LOT 14
 T-9 N; R-8 W
 HOLMES COUNTY, OHIO

NOV 25 '09 PM 2:42

SURVEYED FOR: TARA CORRIGAN

REFERENCES

- DEED VOL. 265 PAGE 886
- O.R. VOL. 9 PAGE 696
- O.R. VOL. 203 PAGE 796
- PLAT VOL. 14 PAGE 236
- PLAT VOL. 16 PAGE 728
- PLAT VOL. 18 PAGE 242
- BEARINGS FROM PLAT VOL. 16 PAGE 728

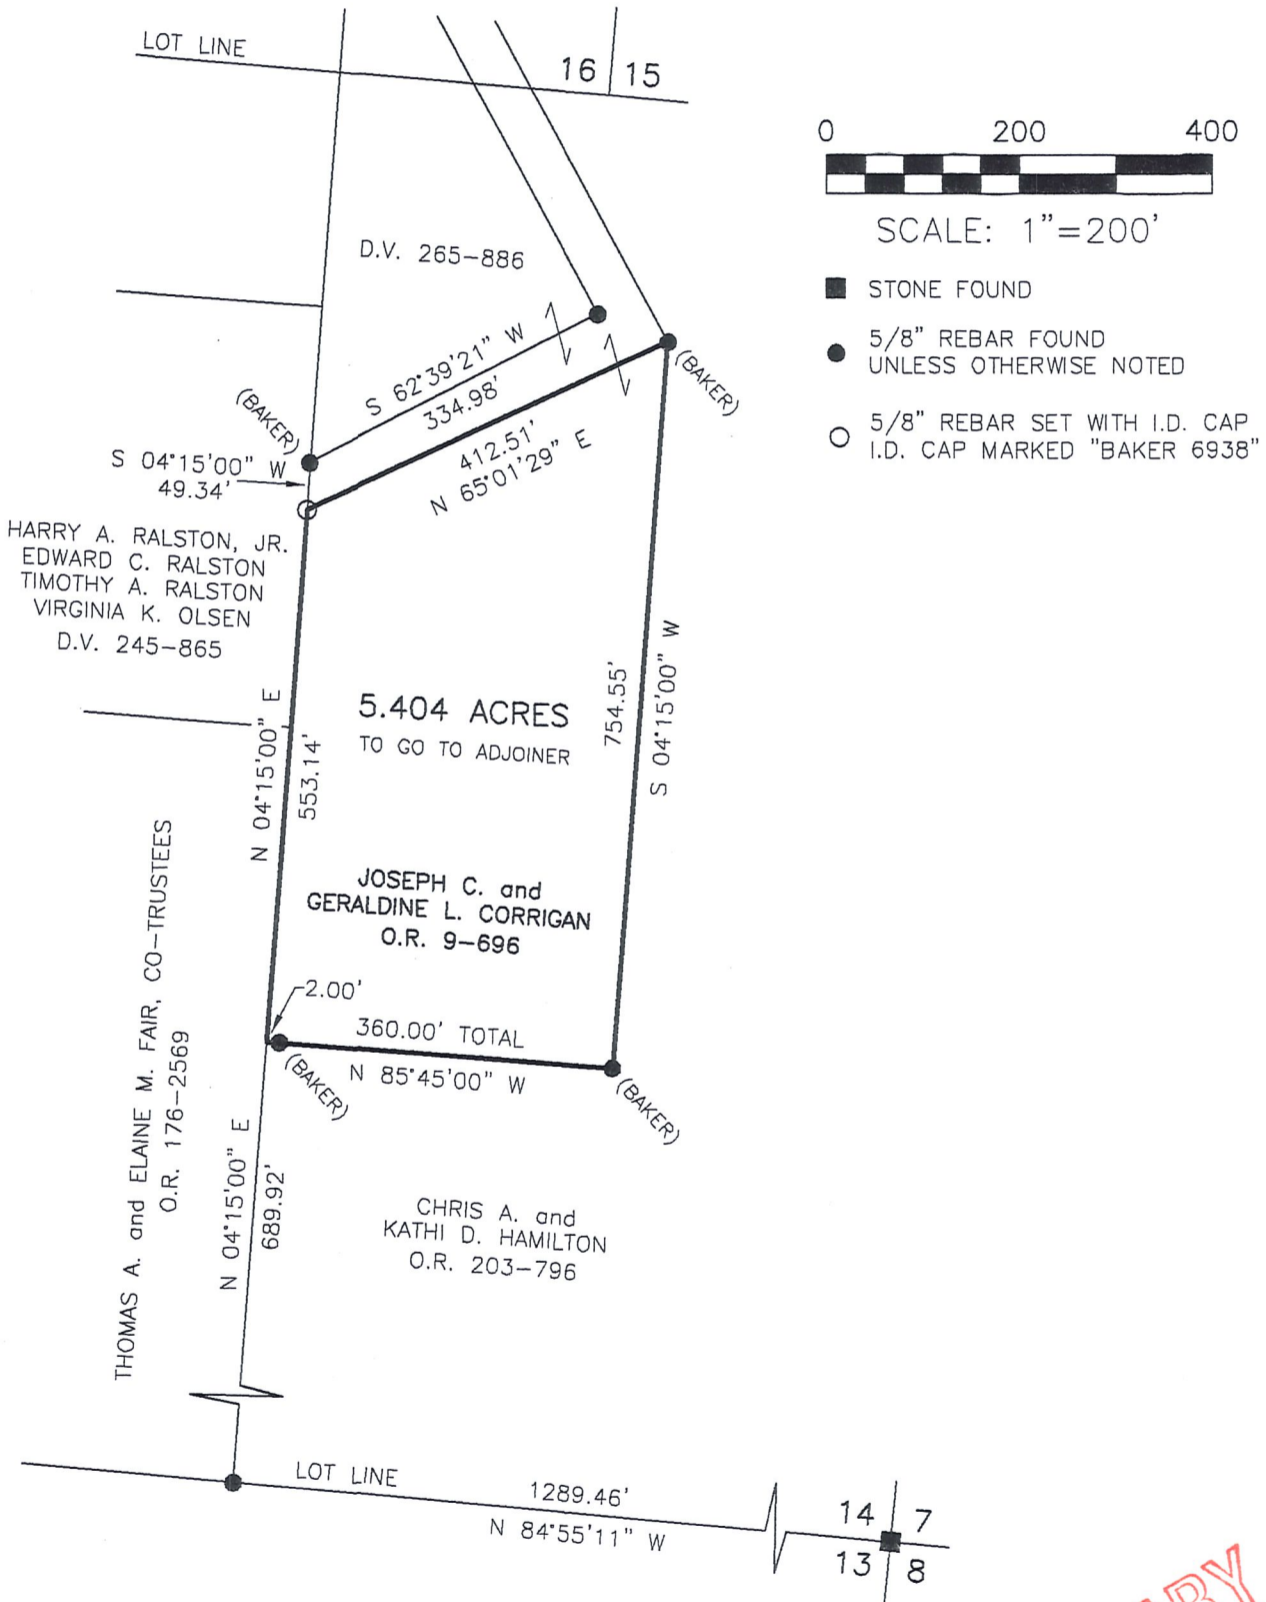

DONALD C. BAKER SURVEYING
 138 N. CLAY STREET
 MILLERSBURG, OHIO 44654
 PH. 330-674-4788
 FAX 330-674-6027

I CERTIFY THIS SURVEY TO BE CORRECT TO THE BEST OF MY KNOWLEDGE.

PRELIMINARY FOR REVIEW ONLY

AARON L. GERBER P.S. 8379
 DATE: NOV. 23, 2009
 ALG\FDB
 FILE NAME: WORK3\S-561-09\ERZ