NOV 25 '09 PM 3:31

PROPERTY LINE SURVEY

MONROE TOWNSHIP
2ND. QTR., LOT 19
T-9 N; R-8 W
HOLMES COUNTY, OHIO

SURVEYED FOR: DELORES KINSEY

REFERENCES

DEED VOL. 191 PAGE 187

O.R. VOL. 58 PAGE 236

PLAT VOL. 7 PAGE 786
PLAT VOL. 13 PAGE 191
PLAT VOL. 15 PAGE 82
PLAT VOL. 18 PAGE 790

BEARINGS FROM DEED VOL. 191 PAGE 187

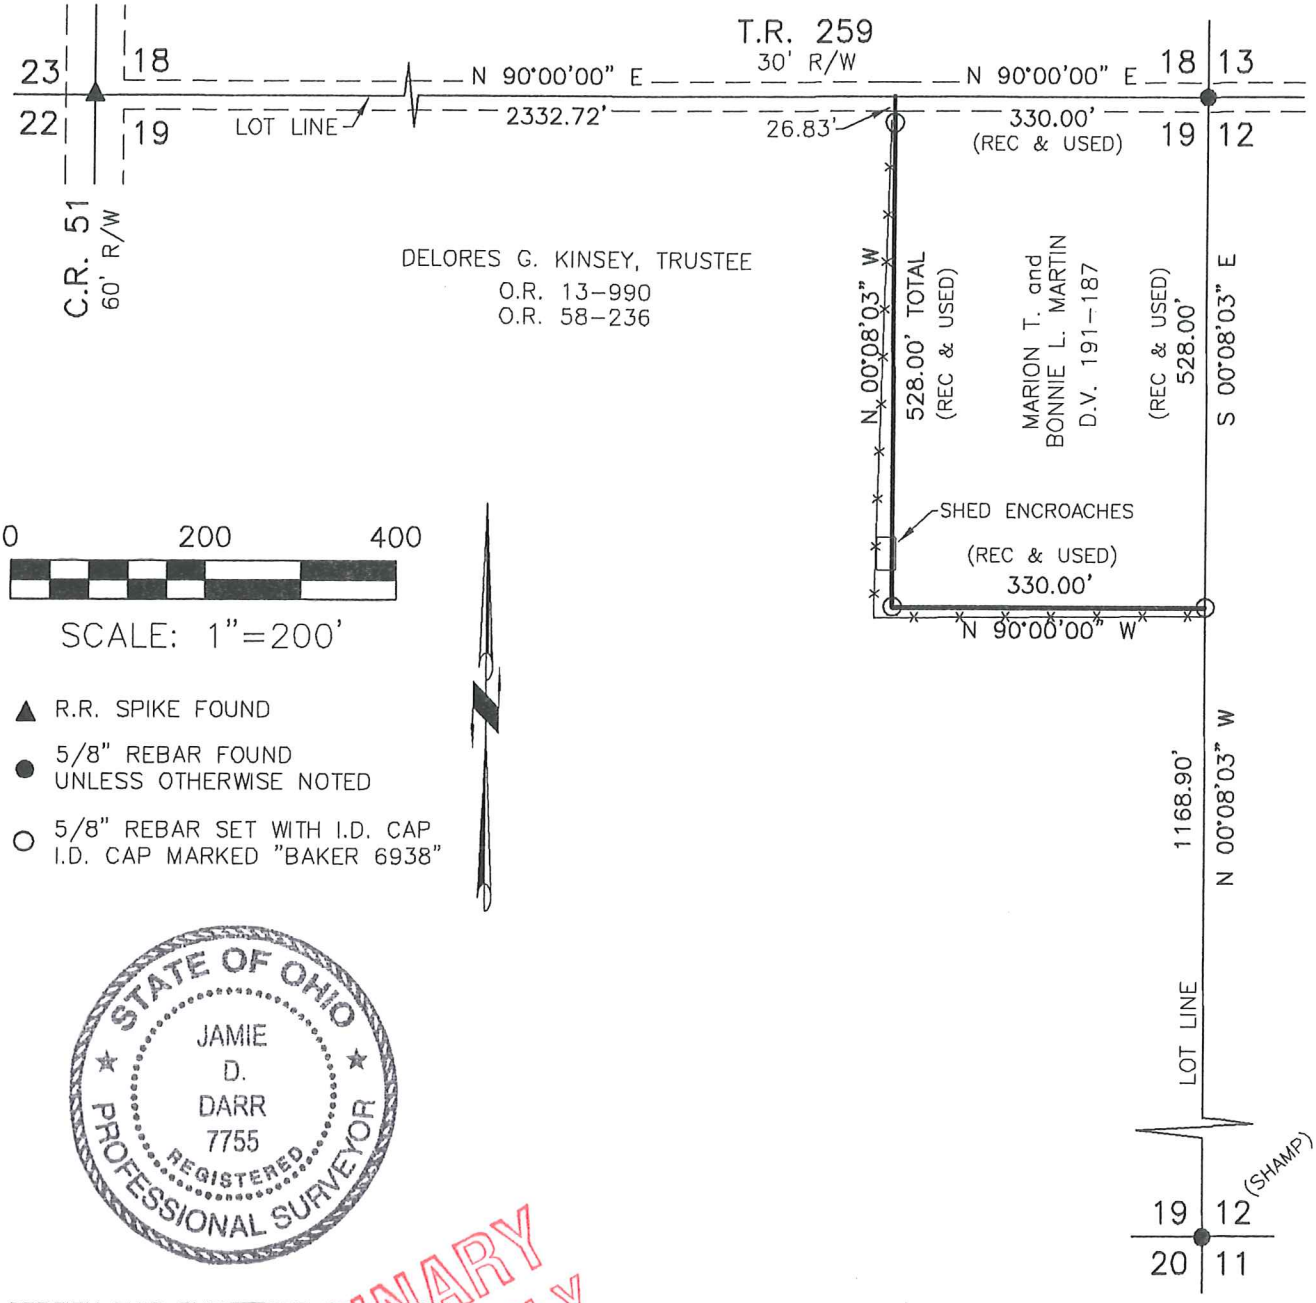

0 200 400

SCALE: 1"=200'

▲ R.R. SPIKE FOUND

● 5/8" REBAR FOUND
UNLESS OTHERWISE NOTED

○ 5/8" REBAR SET WITH I.D. CAP
I.D. CAP MARKED "BAKER 6938"

STATE OF OHIO
JAMIE
D.
DARR
7755
REGISTERED
PROFESSIONAL SURVEYOR

I CERTIFY THIS SURVEY TO BE CORRECT
TO THE BEST OF MY KNOWLEDGE.

JAMIE D. DARR P.S. 7755

DATE: NOV. 24, 2009
JDD\KES
FILE NAME: WORK3\S-550-09\ERZ

PRELIMINARY
FOR REVIEW ONLY

DONALD C. BAKER SURVEYING
138 N. CLAY STREET
MILLERSBURG, OHIO 44654
PH. 330-674-4788
FAX 330-674-6027