



MONROE TOWNSHIP  
 3RD QTR. LOT 5  
 TWP.-9 RANGE-8  
 HOLMES COUNTY, OHIO

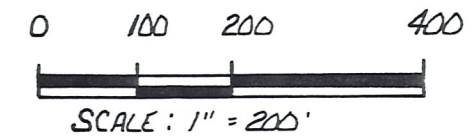

- STONE FOUND
- IRON PIN FOUND
- 9/8" REBAR WITH I.D. CAP SET
- I.D. CAP MARKED "BAKER 6938"

REFERENCES:  
 PLAT VOL. 9 PAGE 37  
 DEED VOL. 232 PAGE 384  
 BEARINGS FROM DEED VOL. 215  
 PAGE 592

MAP OFFICE COPY

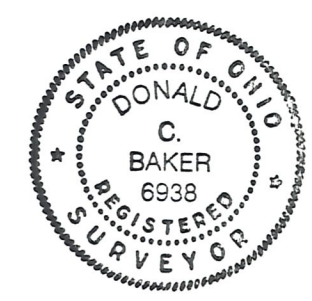

I CERTIFY THIS SURVEY TO BE CORRECT  
 TO THE BEST OF MY KNOWLEDGE.

Donald C. Baker  
 DONALD C. BAKER P.S. 6938  
 4321 T.R. 252  
 GLENMONT, OHIO

JAN. 10, 1990

