

**Monroe Township
3rd Qtr. Lot 13
T-9 N; R-8 W
Holmes County, Ohio**



SURVEYED FOR: Alan Miller

REFERENCES:

Deeds as shown

Plat Vol. 16 Page 720
Plat Vol. 19 Page 2255
Plat Vol. 9 Page 77

Basis of Bearing from Plat Vol. 19 Page 2255.

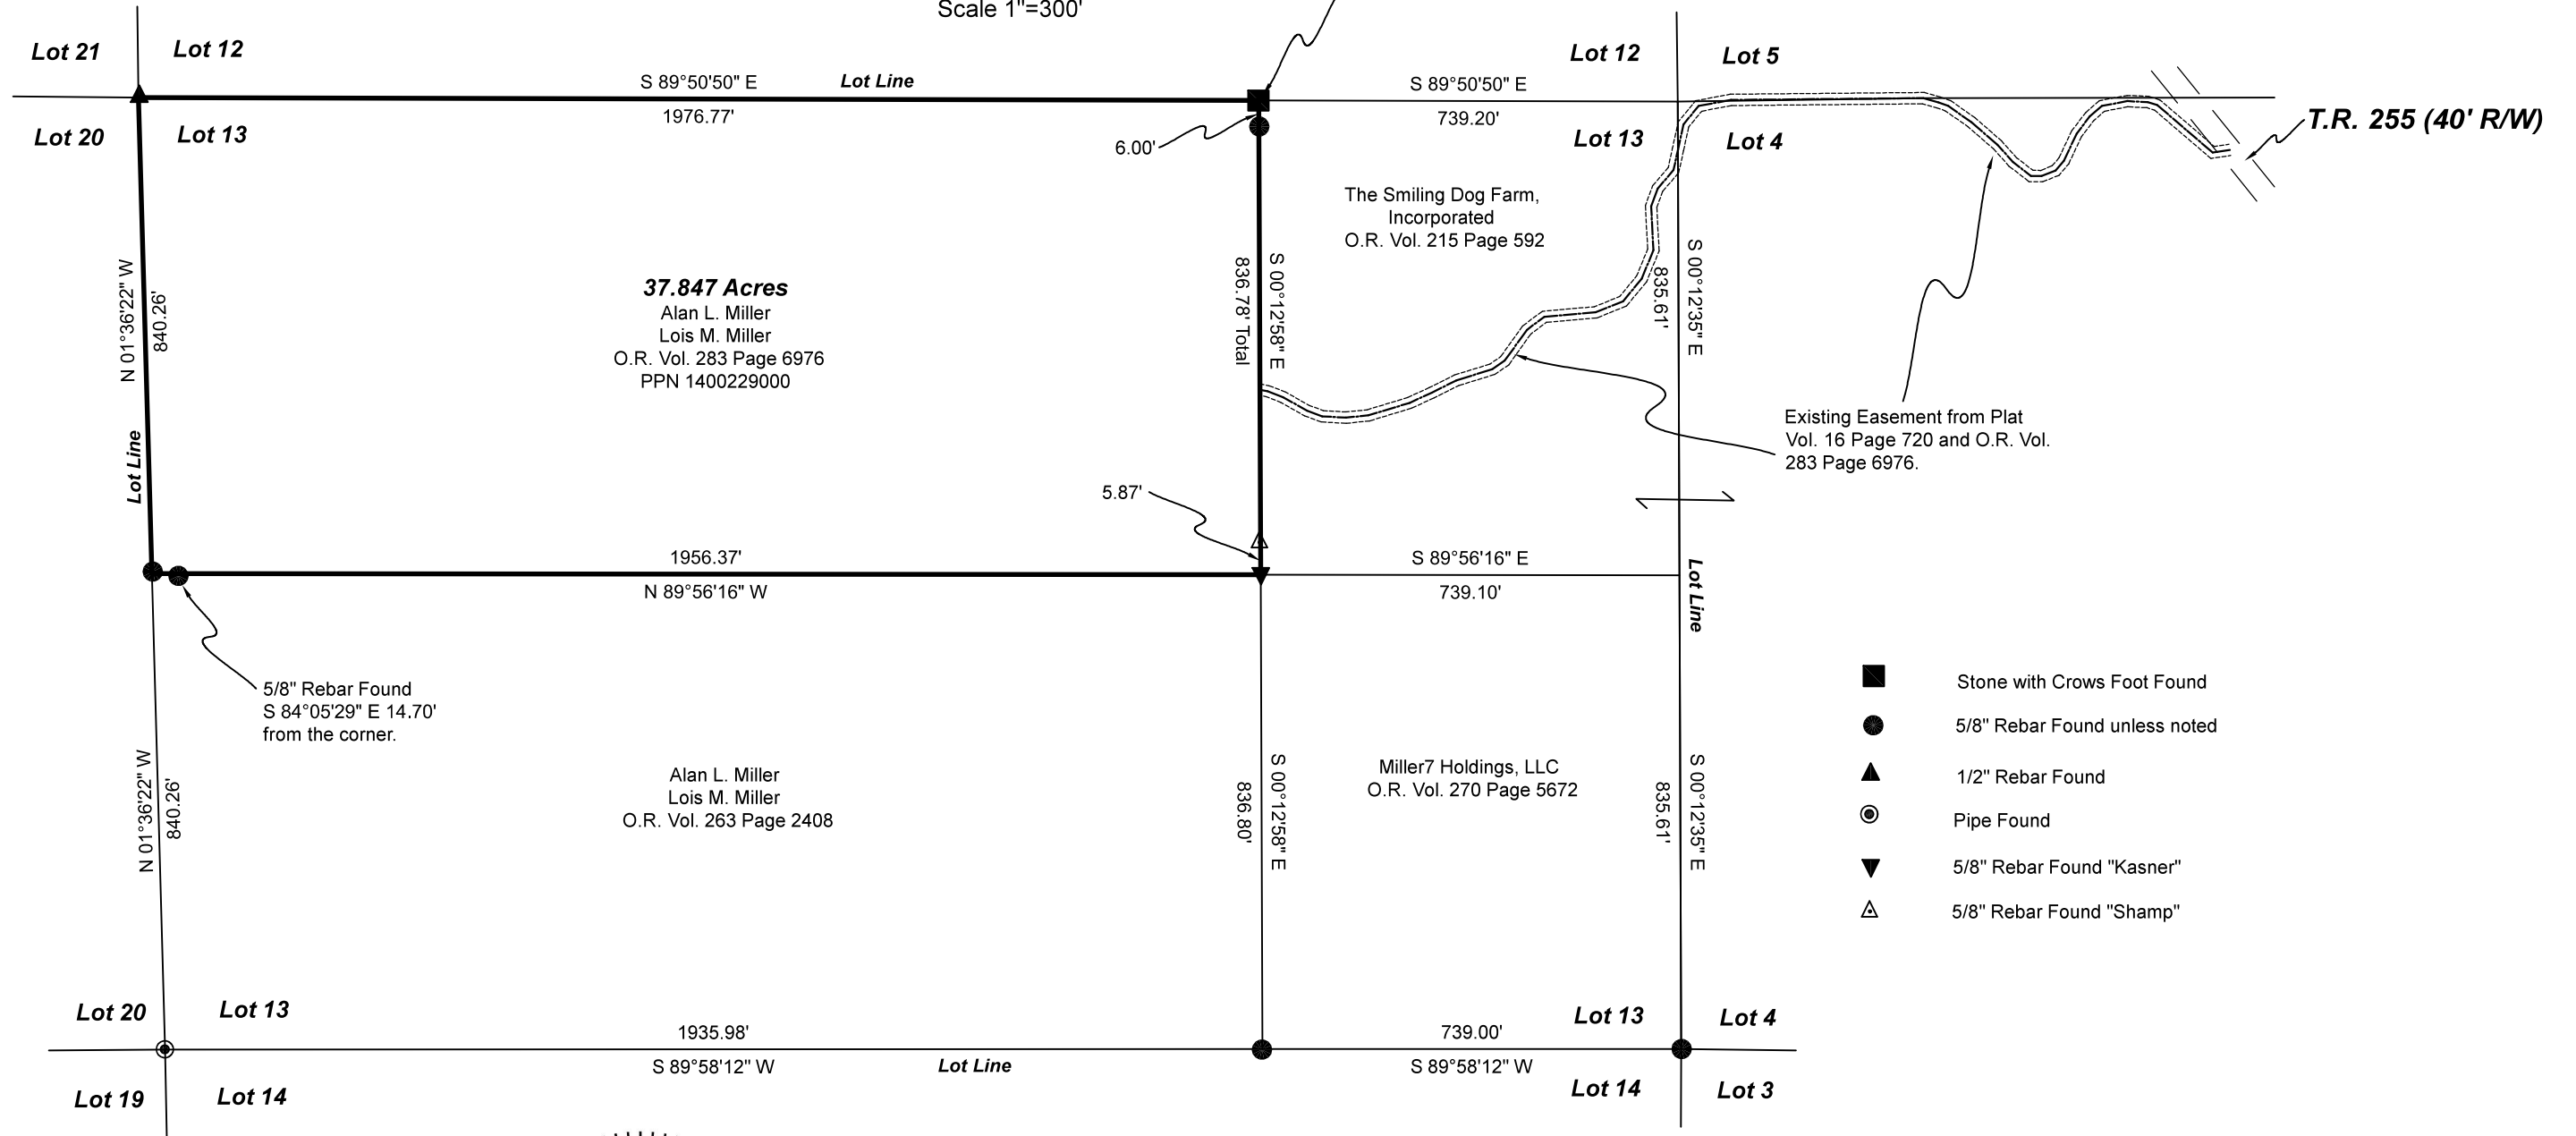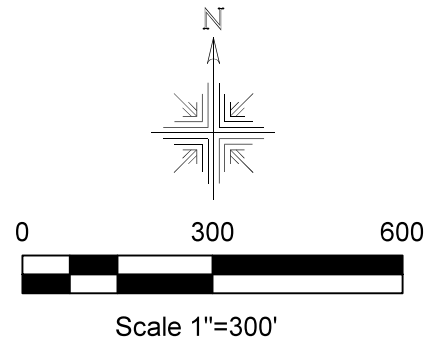

Pioneer Surveying & Services, LLC.
5434 Township Road 377
Millersburg, Ohio 44654
Phone: 330-231-0497
Email: caleb@pioneersurveyingandservices.com



I certify this survey to be correct to the best of my knowledge.

Caleb Galbraith

Caleb Jerome Galbraith P.S. 8703
Date: December 16, 2022
Job ID: 23722-M06

