


RETRACEMENT SURVEY OF O.R. 163-419
MONROE TOWNSHIP
3RD. QTR., LOT 27
T-9 N; R-8 W
HOLMES COUNTY, OHIO

SURVEYED FOR: DON & BARB SHAUM

REFERENCES



DEED VOL. 260 PAGE 495
O.R. VOL. 70 PAGE 233
O.R. VOL. 163 PAGE 419
O.R. VOL. 177 PAGE 3293
O.R. VOL. 196 PAGE 620

PLAT VOL. 5 PAGES 110 & 159
PLAT VOL. 8 PAGE 591
PLAT VOL. 14 PAGE 267
PLAT VOL. 18 PAGES 710 & 713
BEARINGS FROM PLAT VOL. 18 PAGE 713

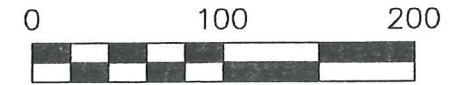

SCALE: 1"=100'


- ▲ R.R. SPIKE FOUND
- 5/8" REBAR FOUND UNLESS OTHERWISE NOTED
- 5/8" REBAR SET WITH I.D. CAP I.D. CAP MARKED "BAKER 6938"

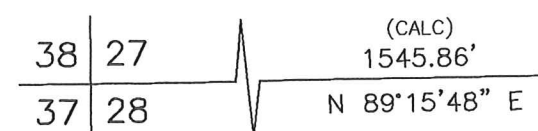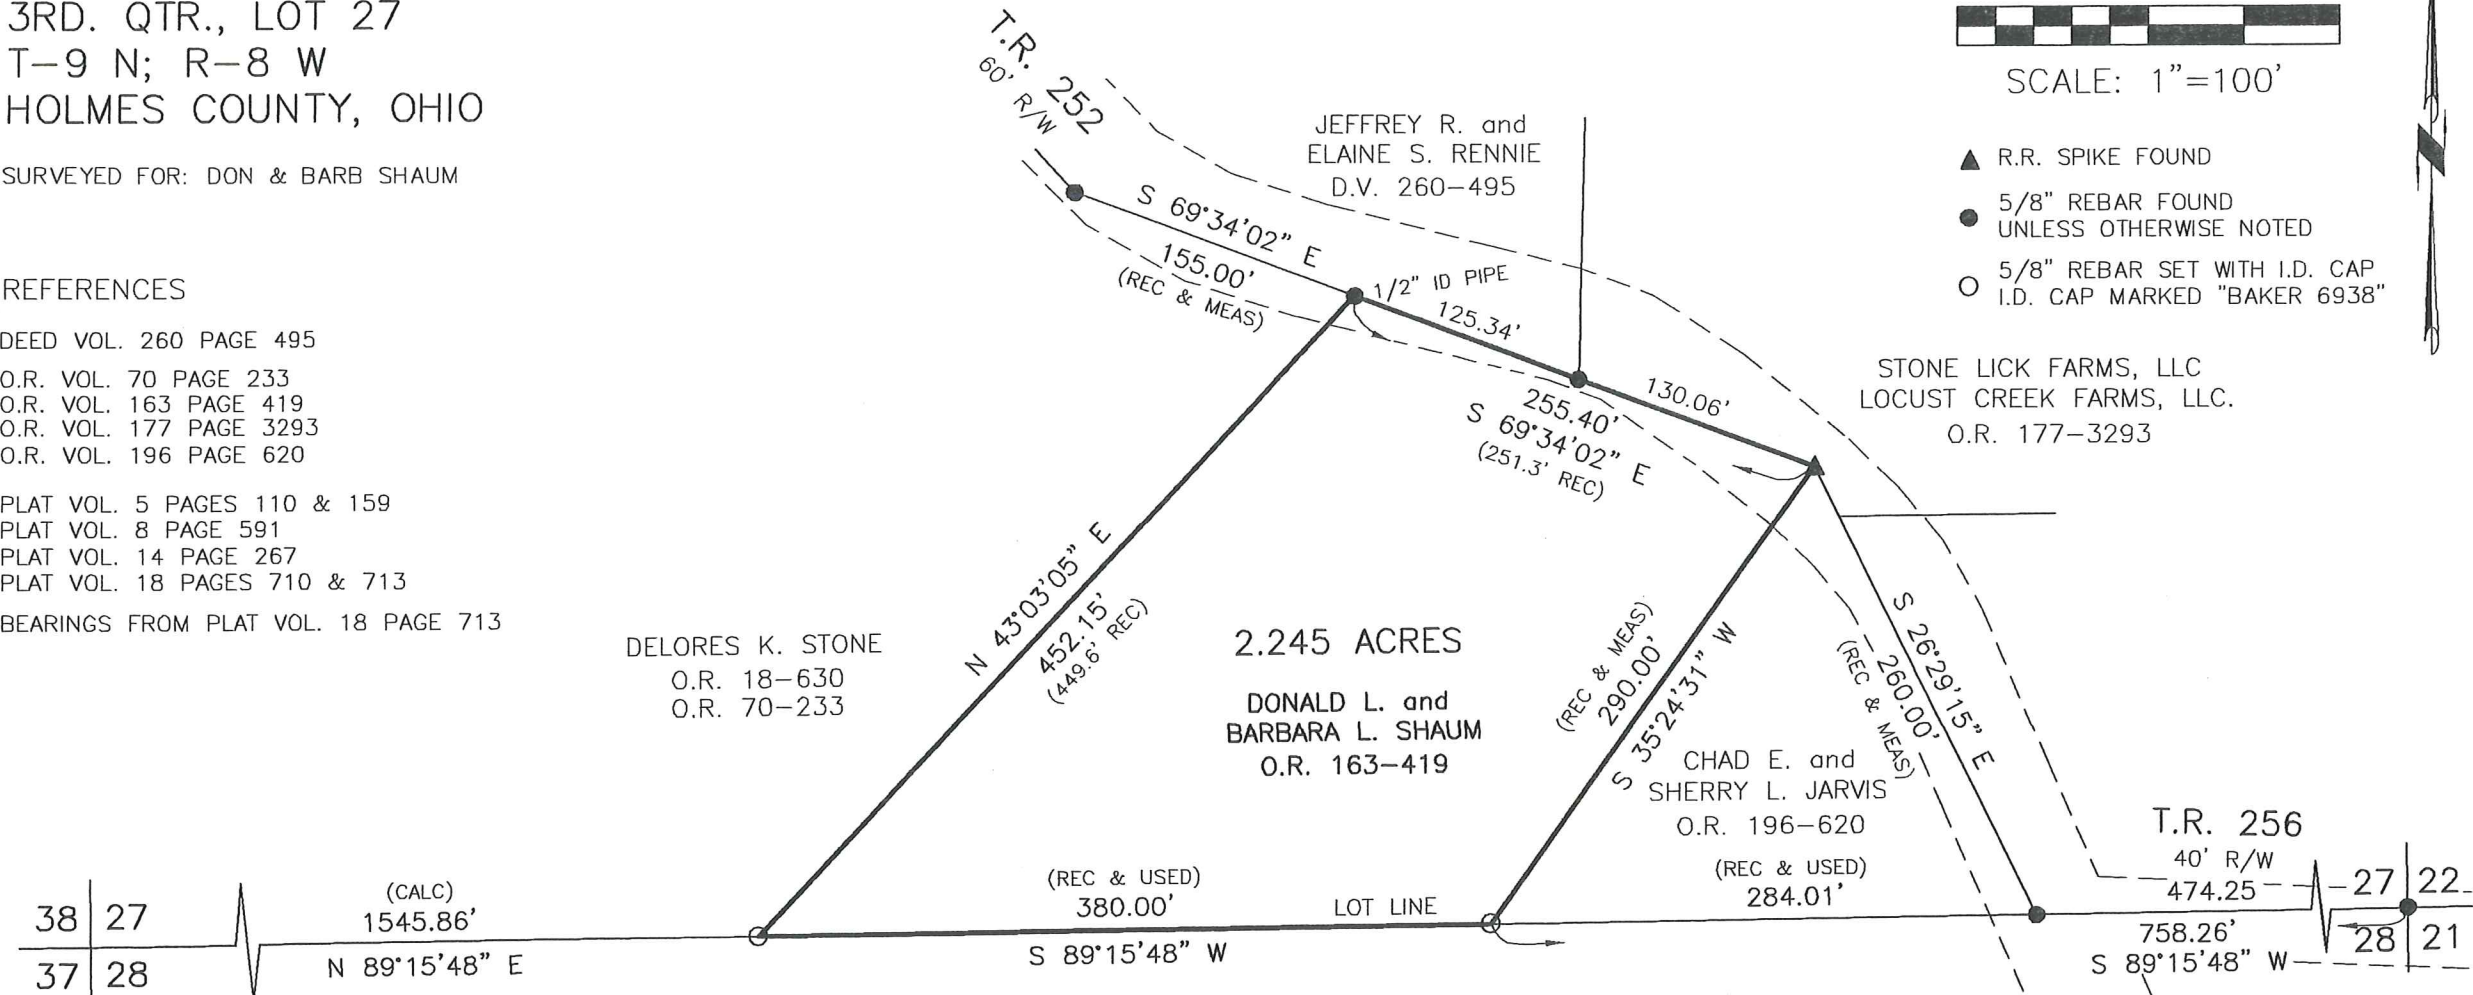

I CERTIFY THIS SURVEY TO BE CORRECT TO THE BEST OF MY KNOWLEDGE.

PRELIMINARY FOR REVIEW ONLY

JAMIE D. DARR P.S. 7755
DATE: NOV. 4, 2009
JDD/ACB
FILE NAME: WORK3\S-510-09\ERZ

 DONALD C. BAKER SURVEYING
138 N. CLAY STREET
MILLERSBURG, OHIO 44654
PH. 330-674-4788
FAX 330-674-6027