

0 100 200 400



SCALE: 1" = 200'


- IRON PIN FOUND
- 4' WOOD STAKE SET
- 5/8" REBAR WITH I.D. CAP SET
I.D. CAP MARKED "BAKER 6938"

REFERENCES:

SURVEY BY BOB KASNER FOR ED MURPHY
VARIOUS DEEDS AS SHOWN

MONROE TOWNSHIP 3RD QTR.
LOTS 28 & 29 T-9N; R-8W
HOLMES COUNTY, OHIO


MAYNARD & BETTY HUMMEL
226-850

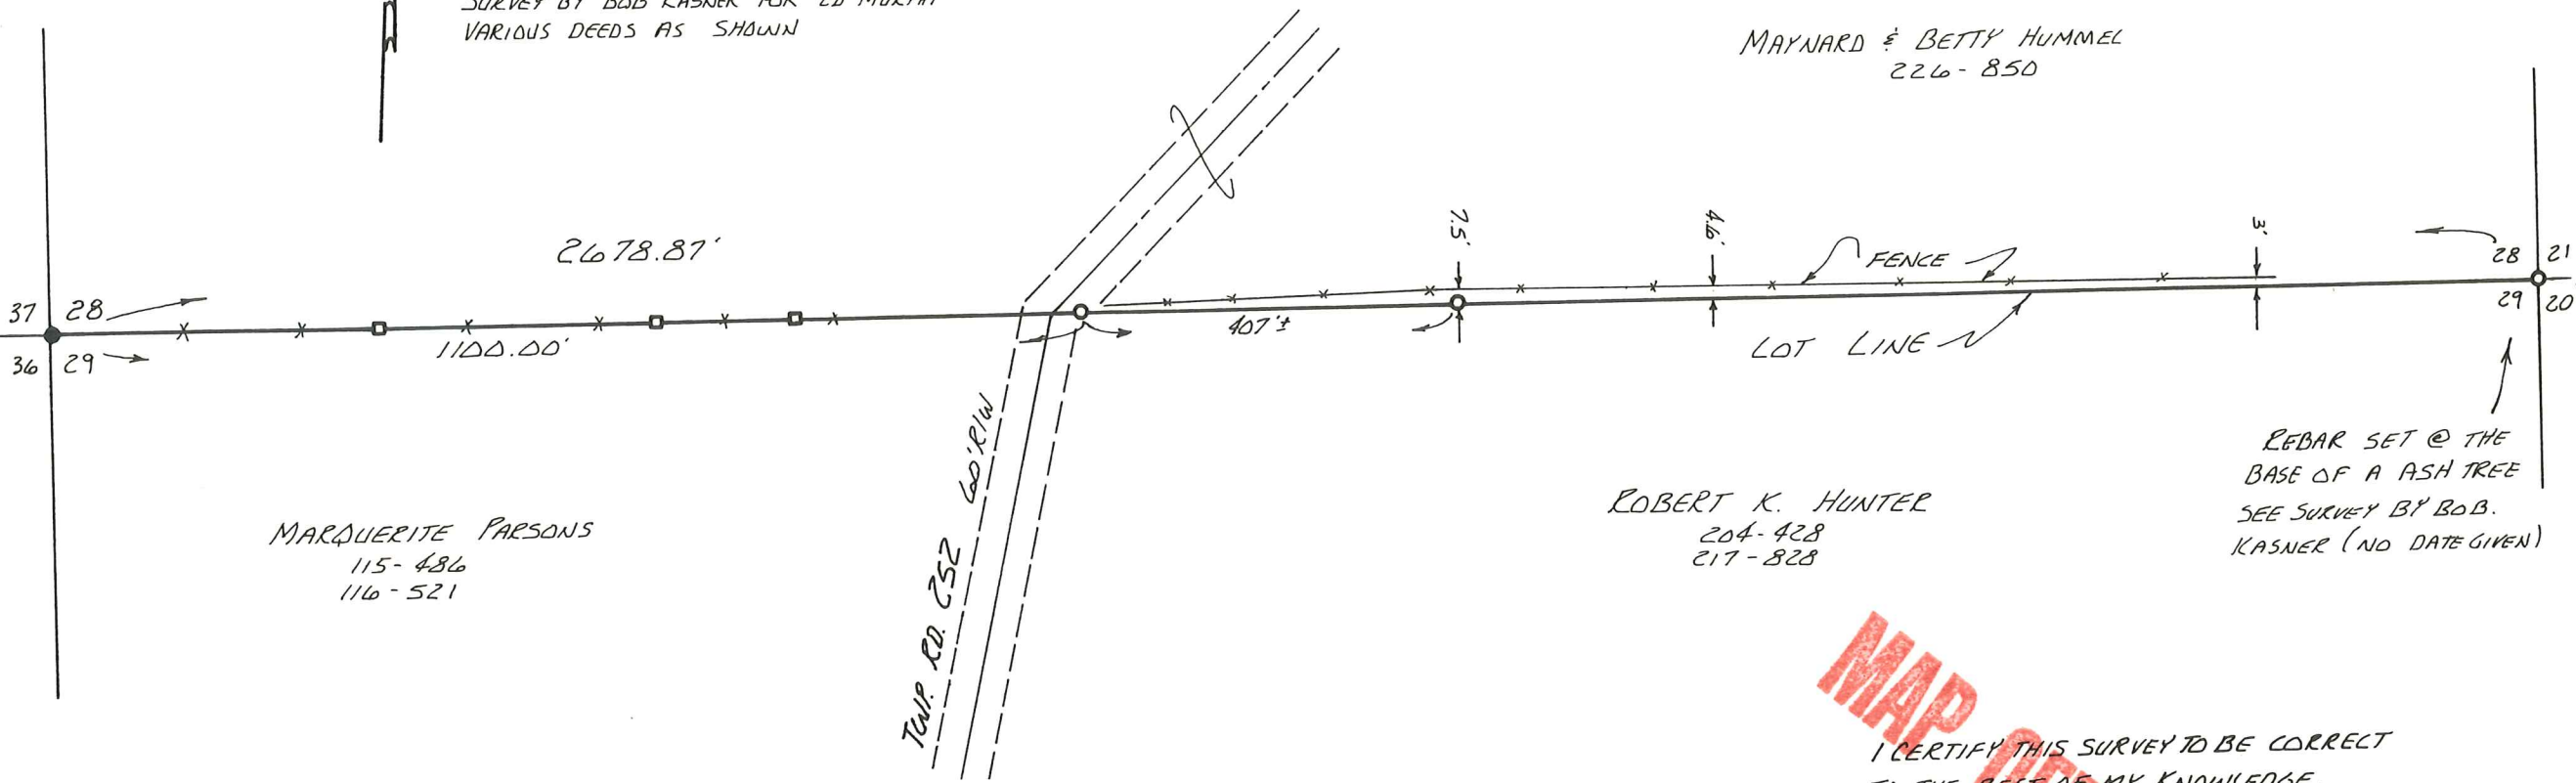

MARQUERITE PARSONS
115-486
116-521

ROBERT K. HUNTER
204-428
217-828

REBAR SET @ THE
BASE OF A ASH TREE
SEE SURVEY BY BOB.
KASNER (NO DATE GIVEN)

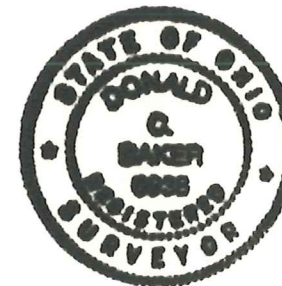

I CERTIFY THIS SURVEY TO BE CORRECT
TO THE BEST OF MY KNOWLEDGE.

Donald C. Baker

DONALD C. BAKER P.S. 6938
4321 TR. 252
GLENMONT OH.

JUNE 25, 1988

MAP COPY COPY