

SCALE: 1"=300'


- 5/8" REBAR FOUND UNLESS OTHERWISE NOTED
- 5/8" REBAR WITH I.D. CAP SET I.D. CAP MARKED "BAKER 6938"

PROPERTY LINE SURVEY

MONROE TOWNSHIP
 3RD. QTR., LOT 35
 T-9 N; R-8 W
 HOLMES COUNTY, OHIO
 SURVEYED FOR: MARK WEST

REFERENCES

DEED VOL. 222 PAGE 757
 O.R. VOL. 182 PAGE 1508
 PLAT VOL. 7 PAGE 600
 PLAT VOL. 9 PAGE 15
 BEARINGS FROM
 PLAT VOL. 9 PAGE 15

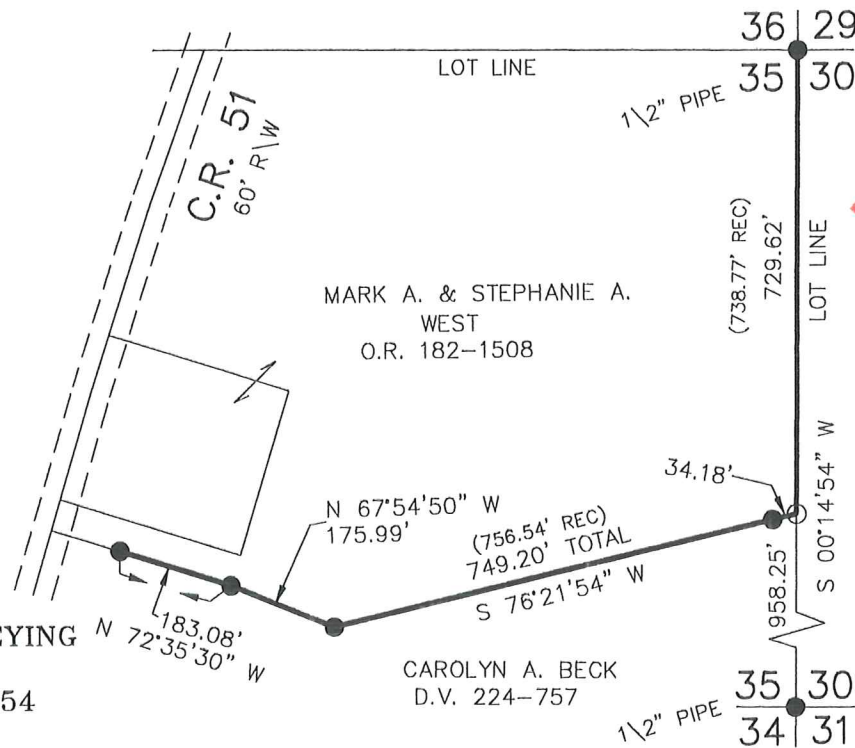

DONALD C. BAKER SURVEYING
 138 N. CLAY ST.
 MILLERSBURG, OHIO, 44654
 PH. 330-674-4788
 FAX. 330-674-6027

MARK A. & STEPHANIE A.
 WEST
 O.R. 182-1508

CAROLYN A. BECK
 D.V. 224-757



I CERTIFY THIS SURVEY TO BE CORRECT TO THE BEST OF MY KNOWLEDGE.

Donald C. Baker

DONALD C. BAKER P.S. 6938
 DATE: FEB. 16, 2006

KES\FDB
 File Name: WORK2\S-16-06