


MONROE TOWNSHIP
 4TH. QTR. LOT 2
 T-9N ; R-8W
 HOLMES COUNTY, OHIO


PROPERTY LINE SURVEY

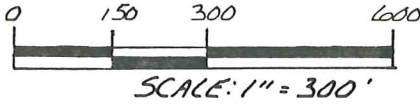

- IRON PIN FOUND
- 5/8" REBAR WITH I.D. CAP SET
 I.D. CAP MARKED "BAKER 6938"


REFERENCES:

DEED VOL. 234 PAGE 475
 DEED VOL. 237 PAGE 101
 BEARINGS FROM PLAT VOL. 10
 PAGE 903

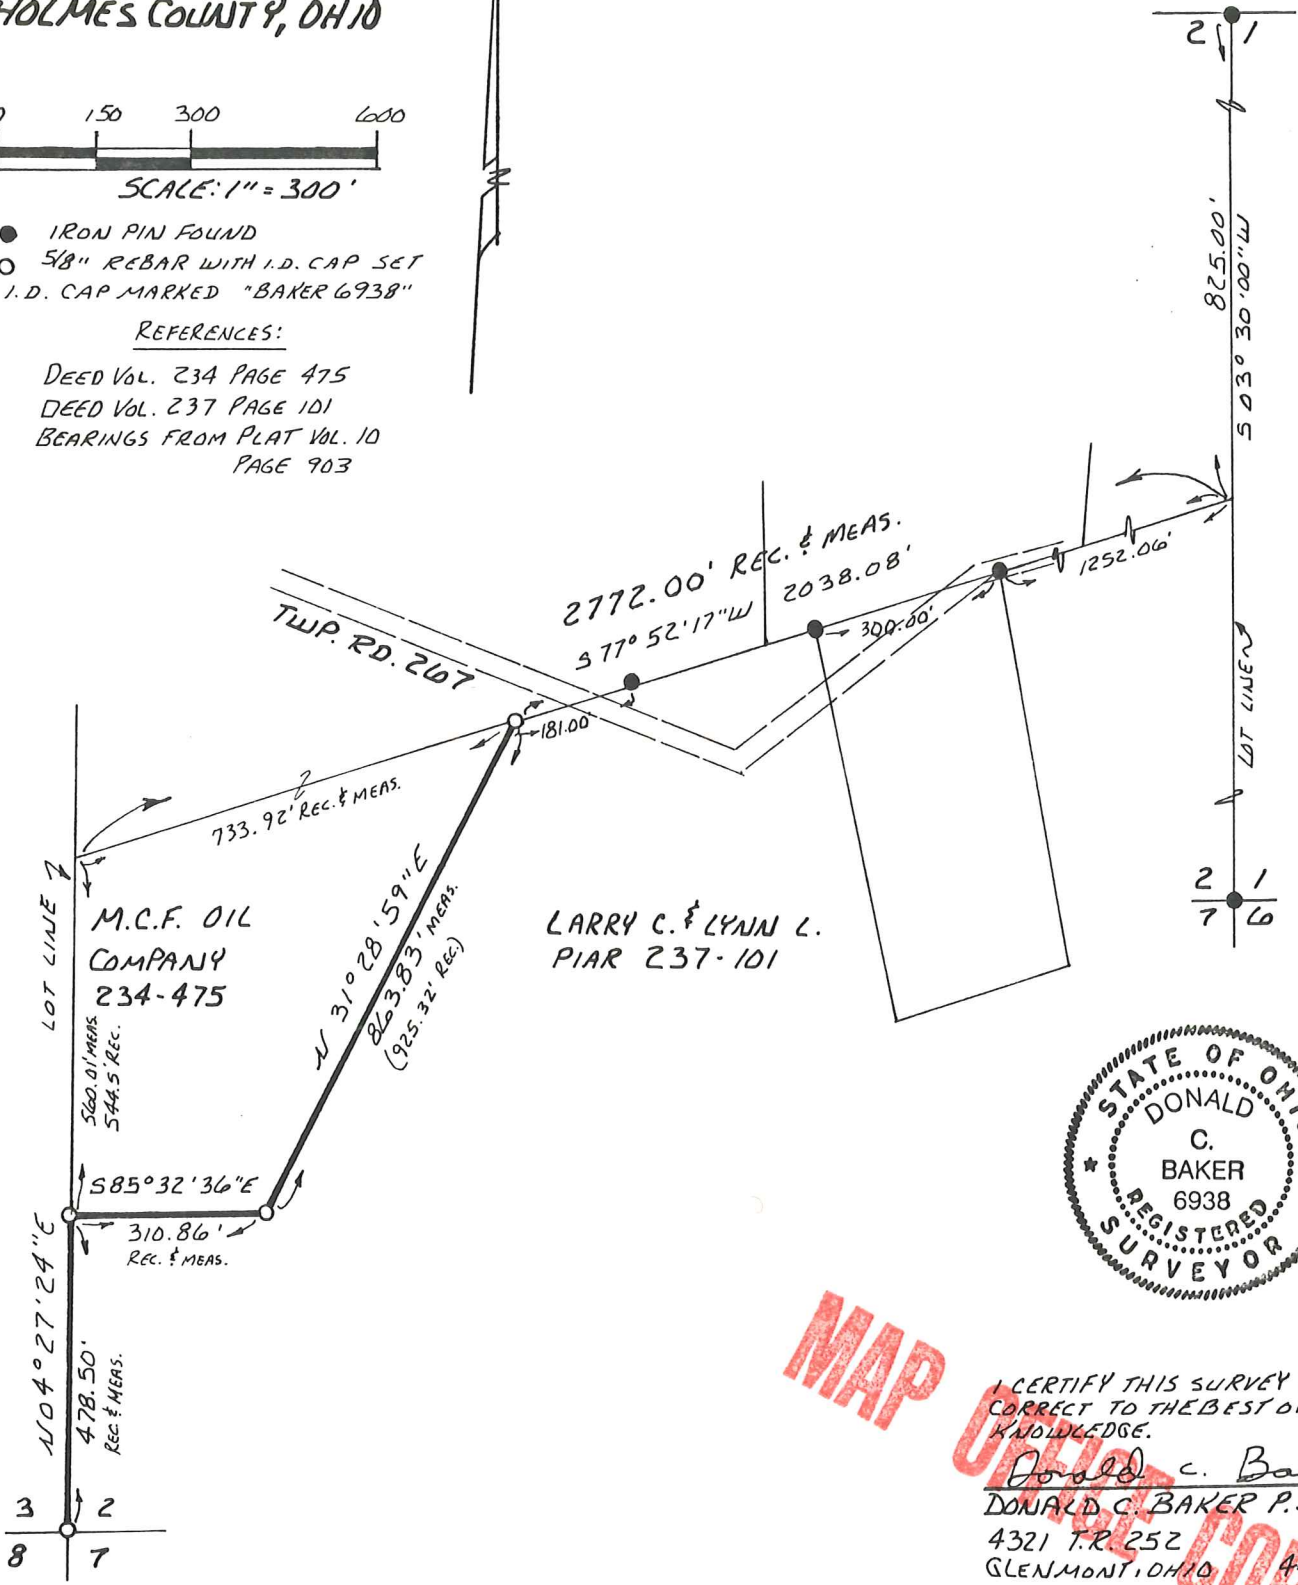

M.C.F. OIL
 COMPANY
 234-475

LARRY C. & LYNN L.
 PIAR 237-101

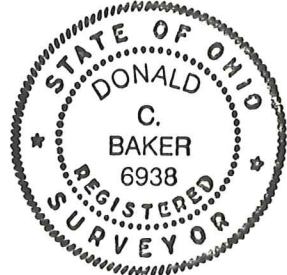

MAP

I CERTIFY THIS SURVEY TO BE
 CORRECT TO THE BEST OF MY
 KNOWLEDGE.

Donald C. Baker
 DONALD C. BAKER P.S. 6938
 4321 T.R. 252
 GLENMONT, OHIO 44628

FEBRUARY 25, 1991