

REFERENCES

O.R. VOL. 183 PAGE 3129
O.R. VOL. 223 PAGE 474
PLAT VOL. 19 PAGE 522
PLAT VOL. 17 PAGE 640
BEARINGS FROM
PLAT VOL. 19 PAGE 522

0 300 600




SCALE: 1"=300'

- ▲ R.R. SPIKE FOUND
- 5/8" REBAR FOUND UNLESS OTHERWISE NOTED
- 5/8" REBAR SET WITH I.D. CAP I.D. CAP MARKED "BAKER 6938"

MONROE TOWNSHIP
4TH. QTR., LOT 21
T-9 N; R-8 W
HOLMES COUNTY, OHIO

SURVEYED FOR: CONRAD MILLER

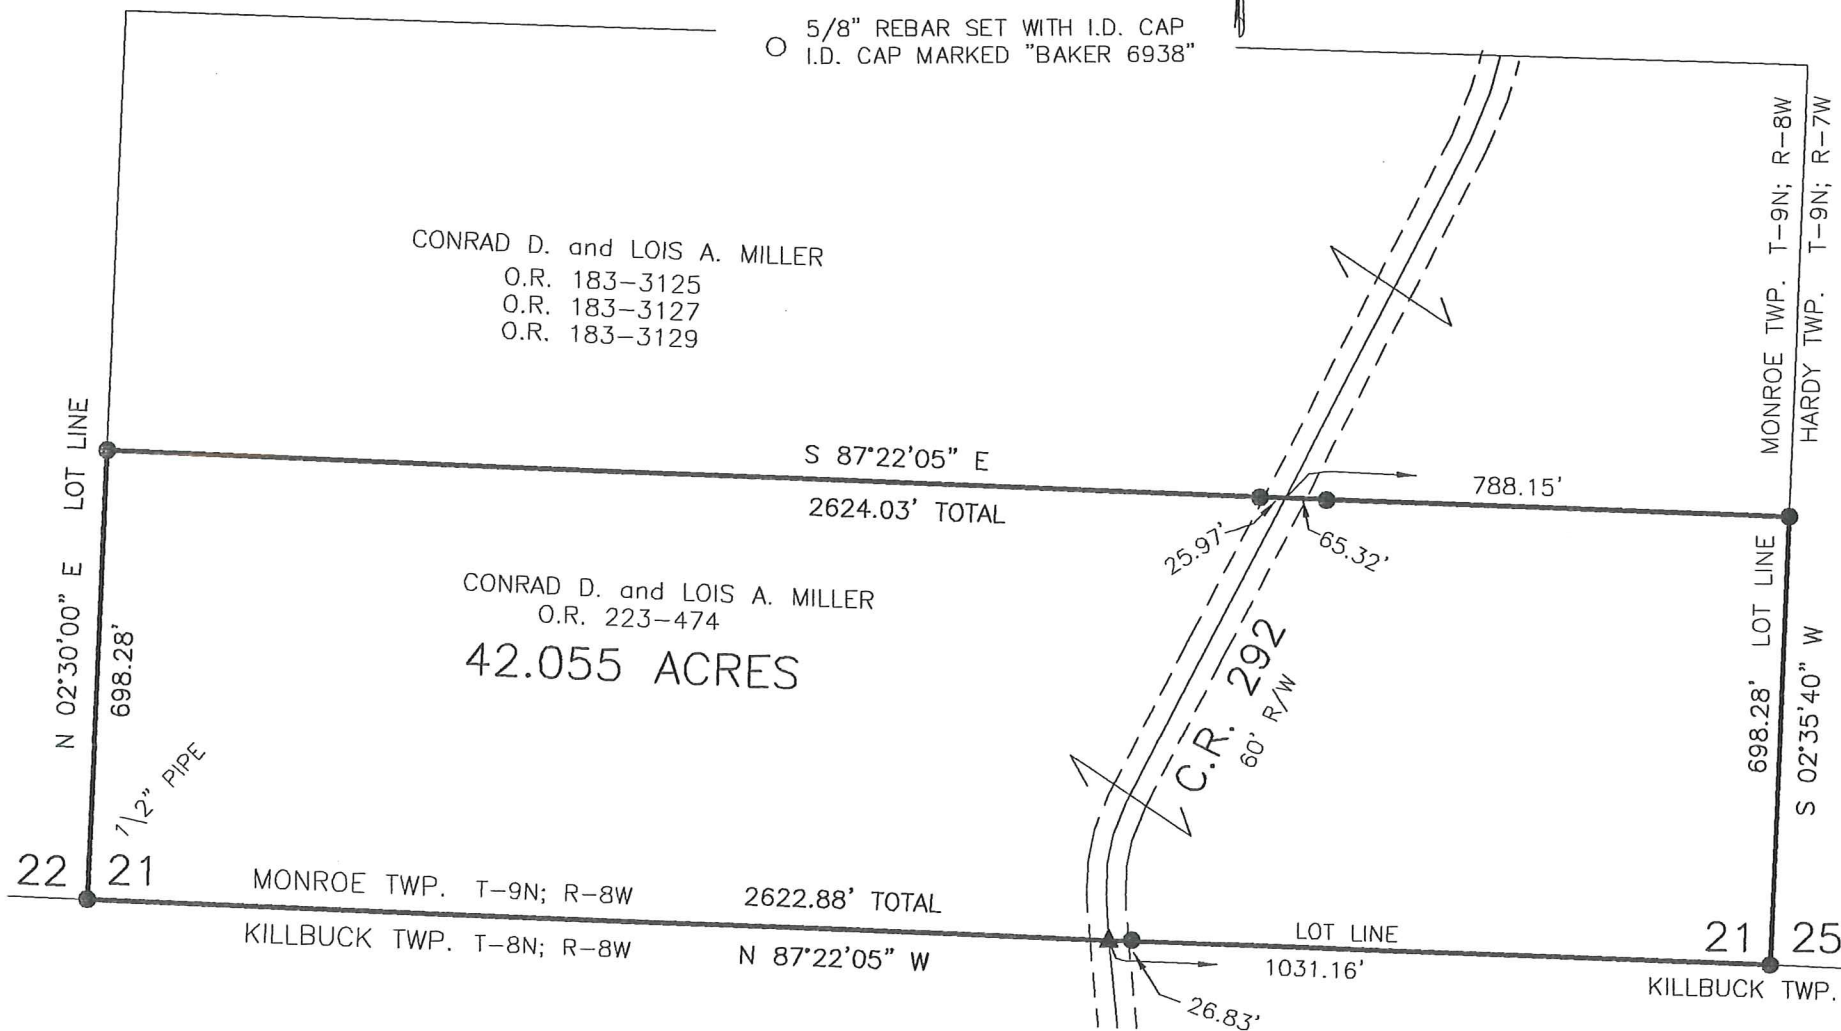

I CERTIFY THIS SURVEY TO BE CORRECT TO THE BEST OF MY KNOWLEDGE.

JAMIE D. DARR P.S. 7755
DATE: FEB. 24, 2011
JDD\ERZ
FILE NAME: WORK3\S-45-11



DONALD C. BAKER SURVEYING
138 N. CLAY STREET
MILLERSBURG, OHIO 44654
PH. 330-674-4788
FAX 330-674-6027

PRELIMINARY FOR REVIEW ONLY