



PAINT TOWNSHIP
 3RD. QTR. LOT 23
 T-10N1R-4W
 HOLMES COUNTY, OHIO

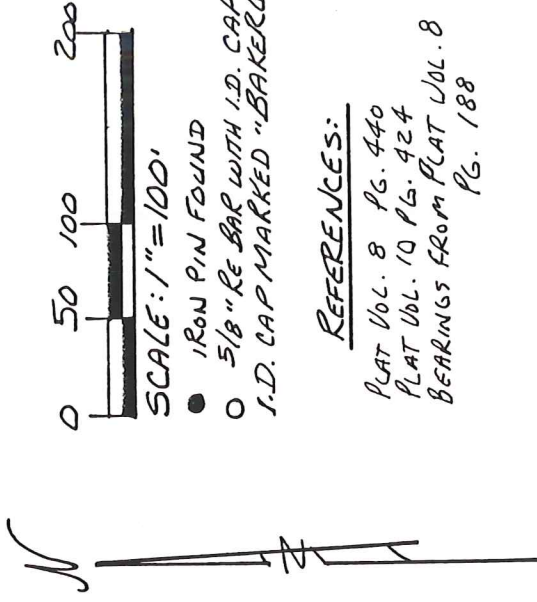

REFERENCES:

PLAT VOL. 8 PG. 440
 PLAT VOL. 10 PG. 424
 BEARINGS FROM PLAT VOL. 8
 PG. 188

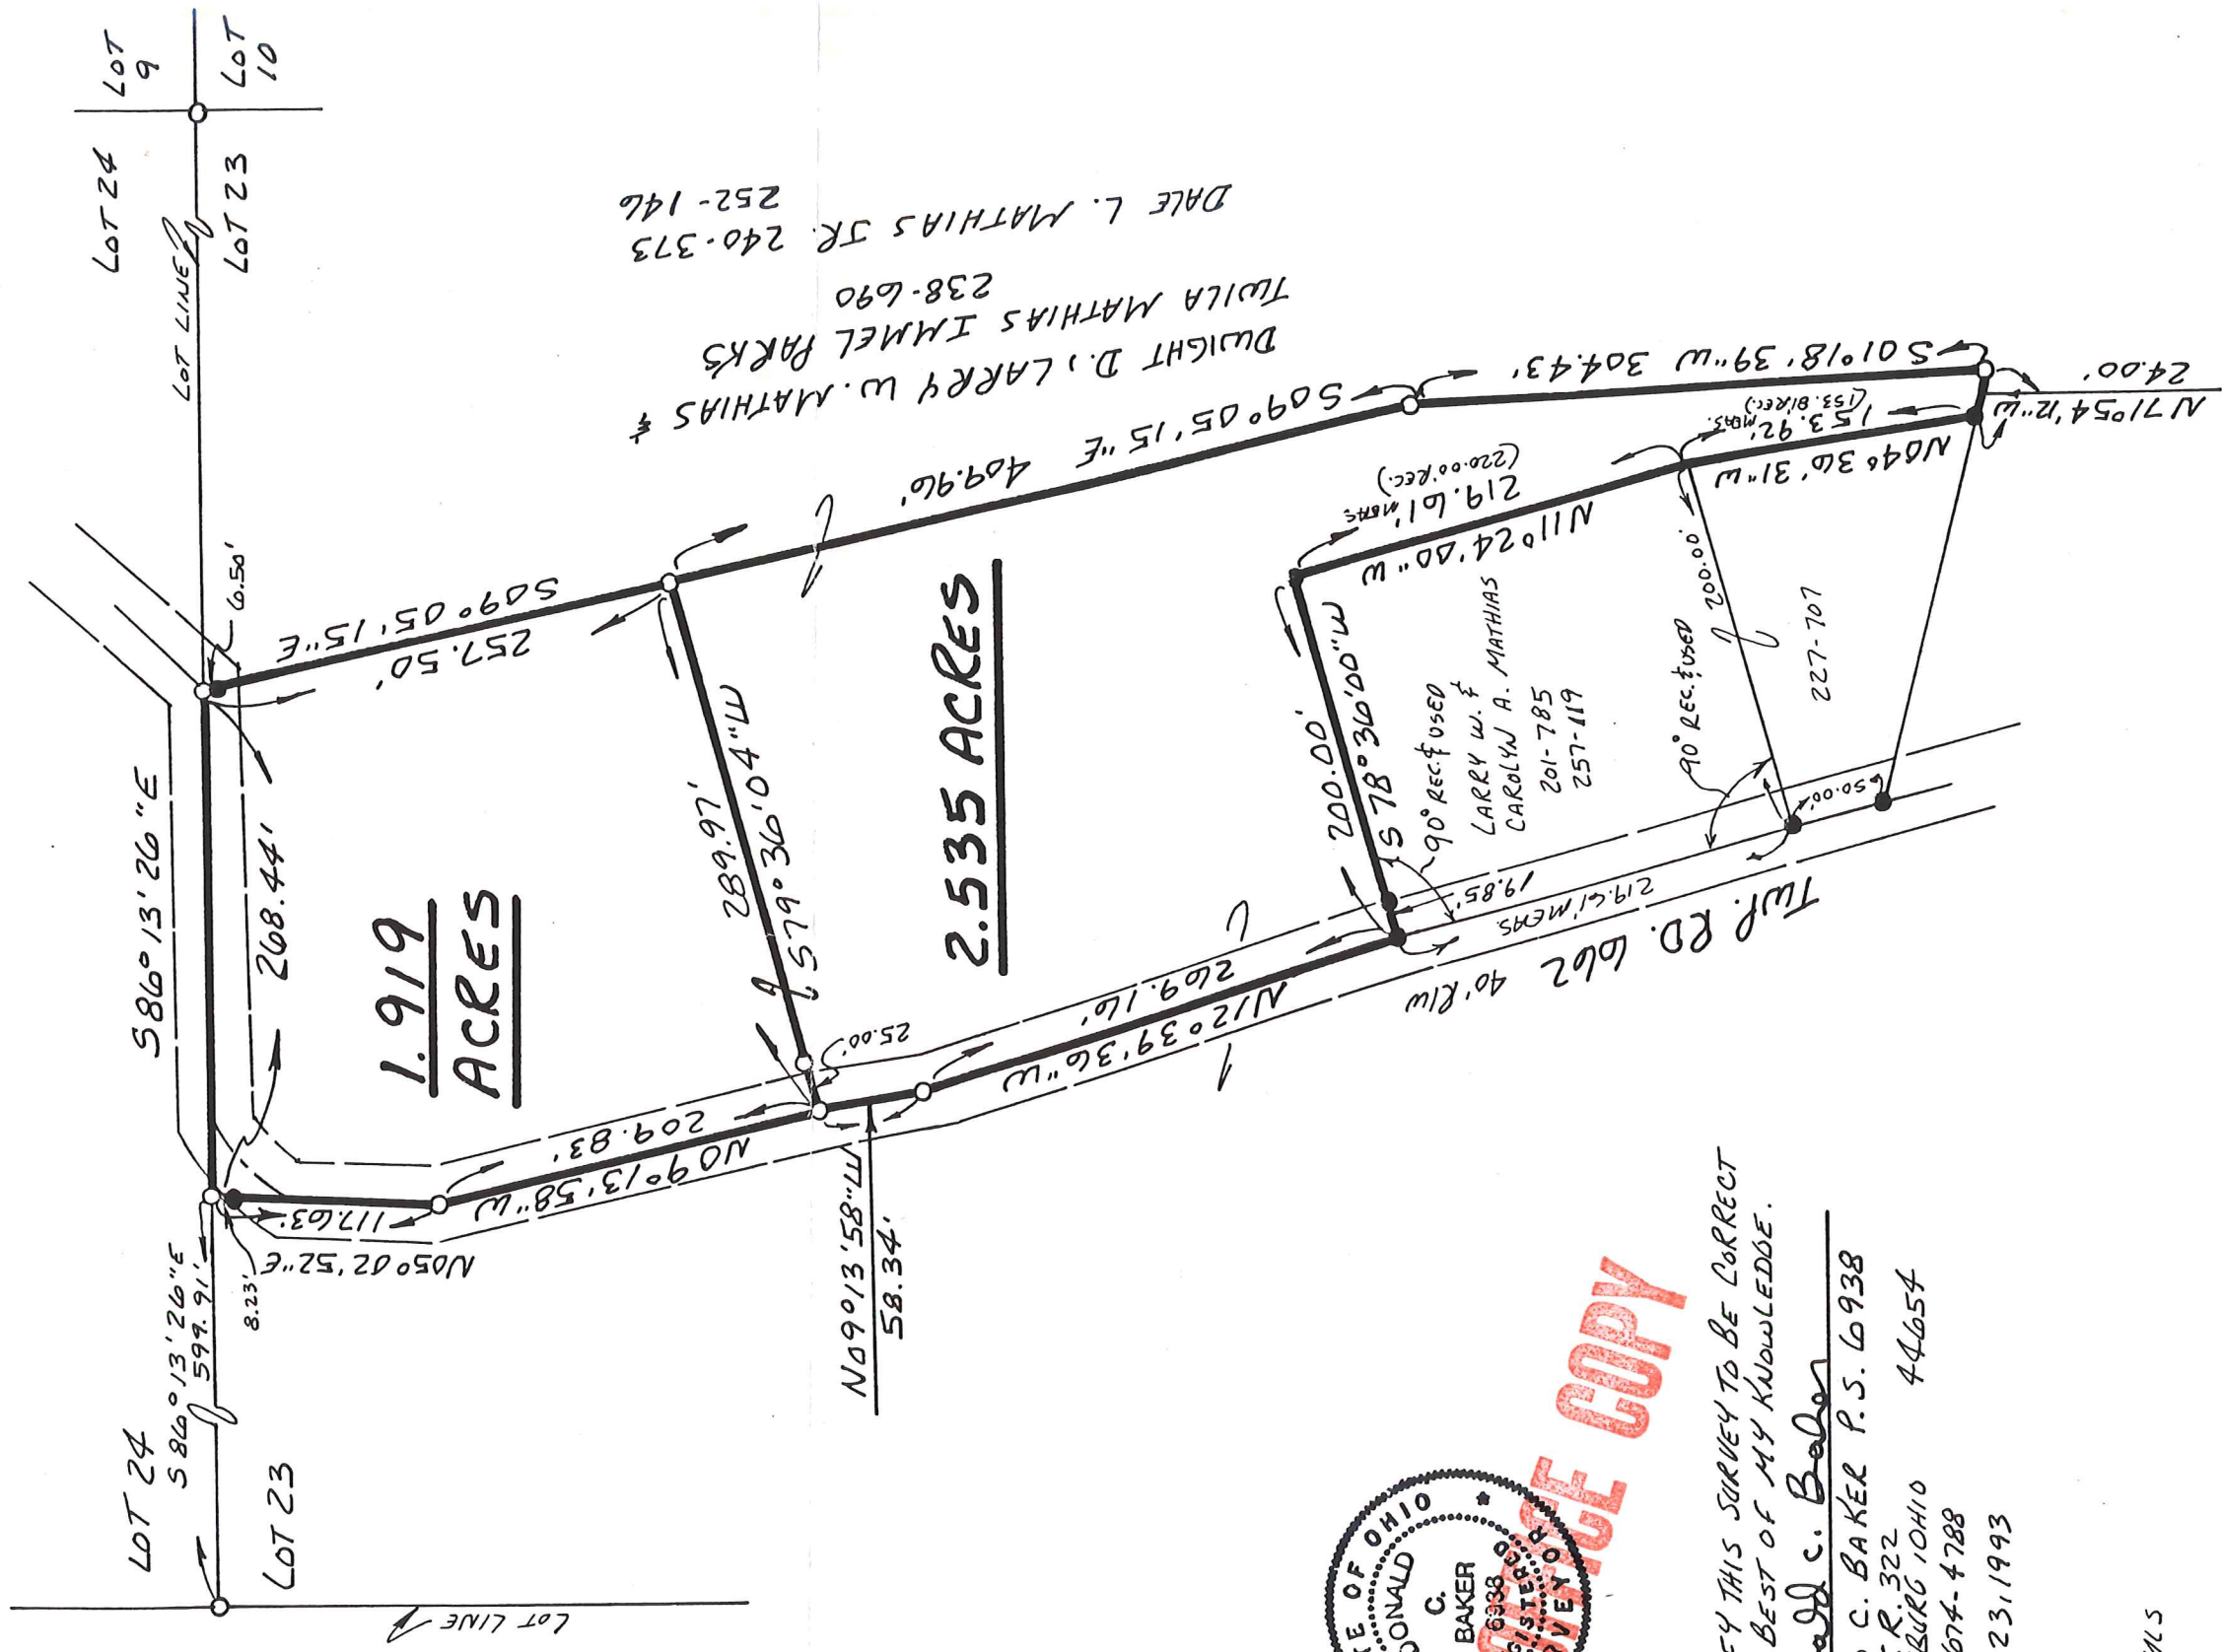

MAP DUPLICATE COPY

I CERTIFY THIS SURVEY TO BE CORRECT
 TO THE BEST OF MY KNOWLEDGE.

Donald C. Baker
 DONALD C. BAKER P.S. 6938
 5958 T.R. 322
 MILLERSBURG, OHIO 44654
 PH (216) 674-4788
 APRIL 23, 1993