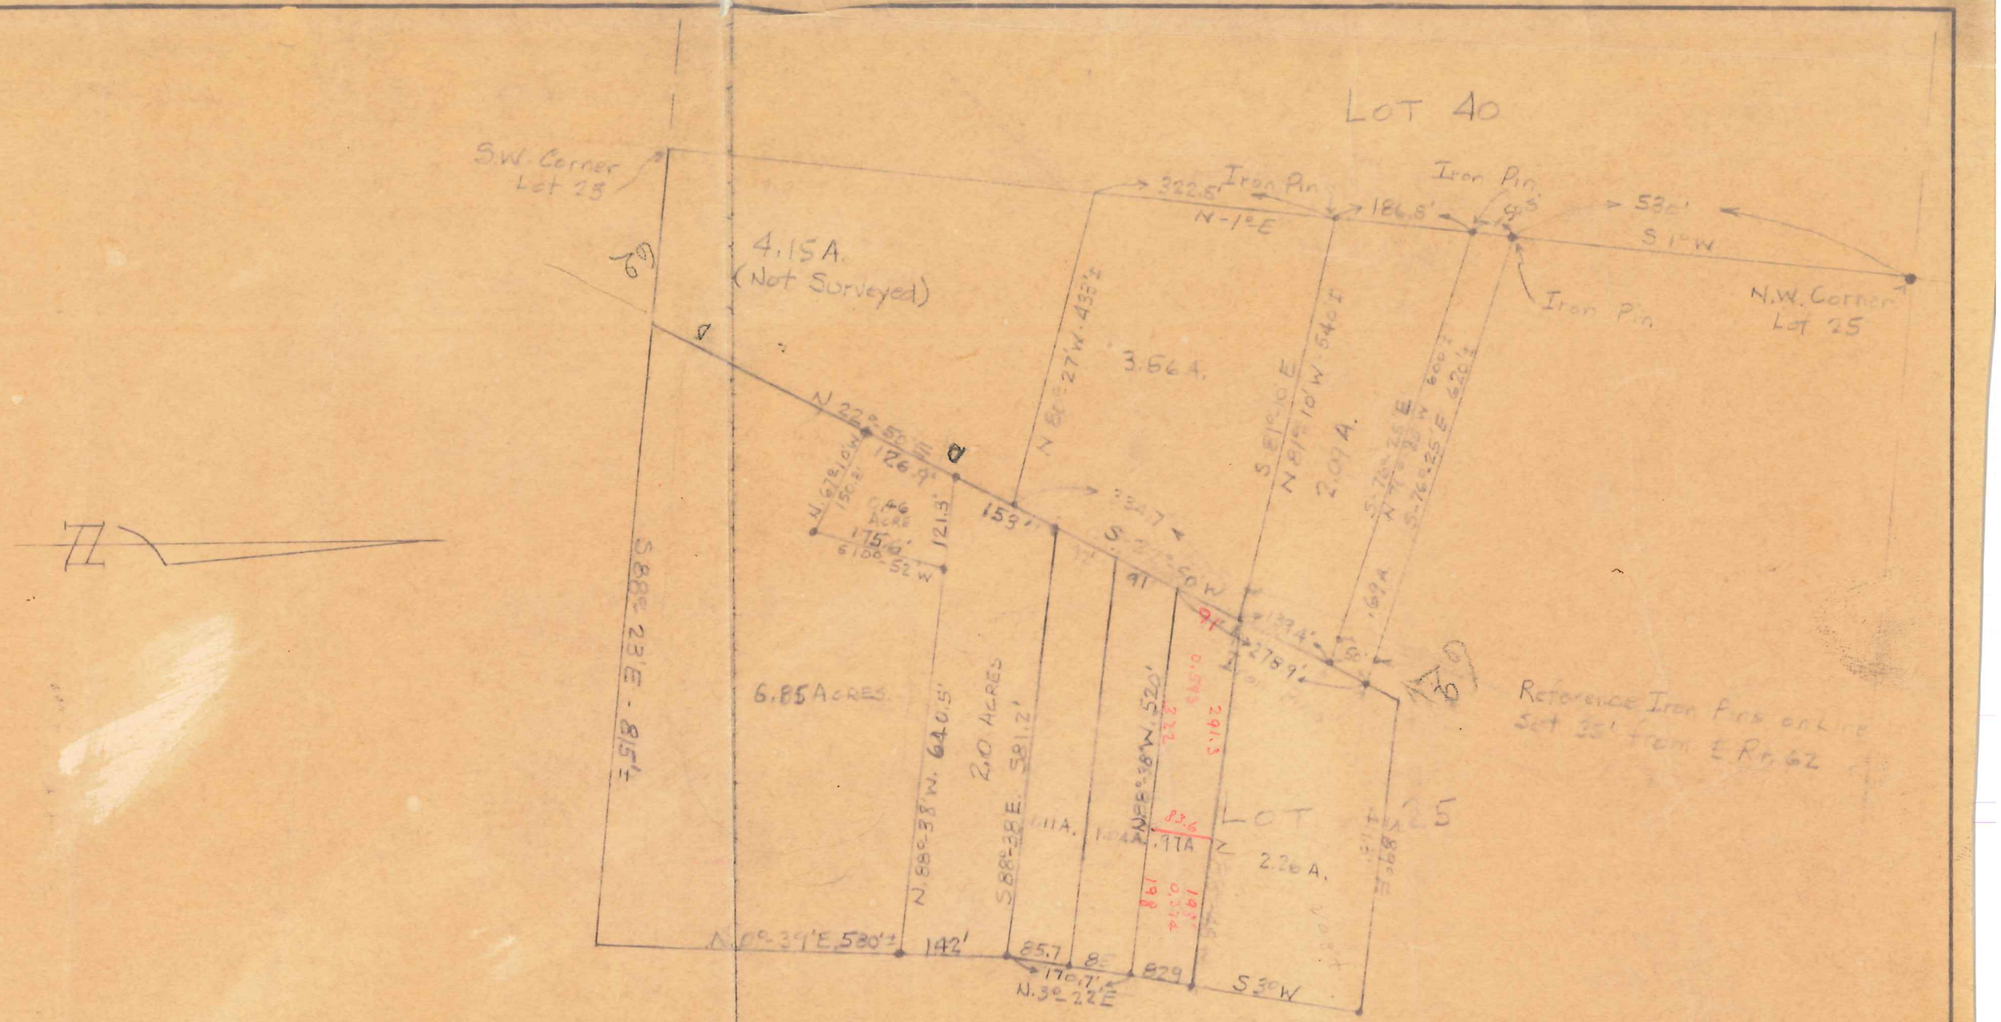

Survey by Richard H Housinger
Corners Marked as shown

MAP OFFICE COPY

RICHARD H. HOUSINGER REG. No. 6685		BREWSTER, OHIO

SURVEY OF PART OF LOT 25
3RD QUARTER; T10; R-4 PAINT TWP.
HOLMES COUNTY, OHIO

SCALE 1"=200'	DATE 5-20 19 54	FILE 10

DRAWN BY RHH.
CHECKED BY RCS

REV 2-2-57