


RETRACEMENT SURVEY OF D.V. 206-690

PAINT TOWNSHIP  
3RD. QTR., LOT 26  
T-10 N; R-4 W  
HOLMES COUNTY, OHIO

SURVEYED FOR: FREEMAN MILLER



REFERENCES

- DEED VOL. 206 PAGE 690
- O.R. VOL. 122 PAGE 747
- PLAT VOL. 4 PAGE 84
- PLAT VOL. 12 PAGE 868
- PLAT VOL. 18 PAGE 382
- BEARINGS FROM PLAT VOL. 18 PAGE 382

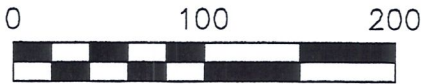

SCALE: 1"=100'

- STONE FOUND
- 5/8" REBAR FOUND UNLESS OTHERWISE NOTED
- 5/8" REBAR SET WITH I.D. CAP I.D. CAP MARKED "BAKER 6938"

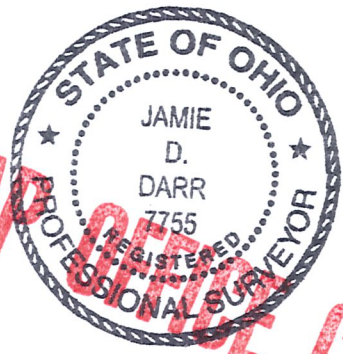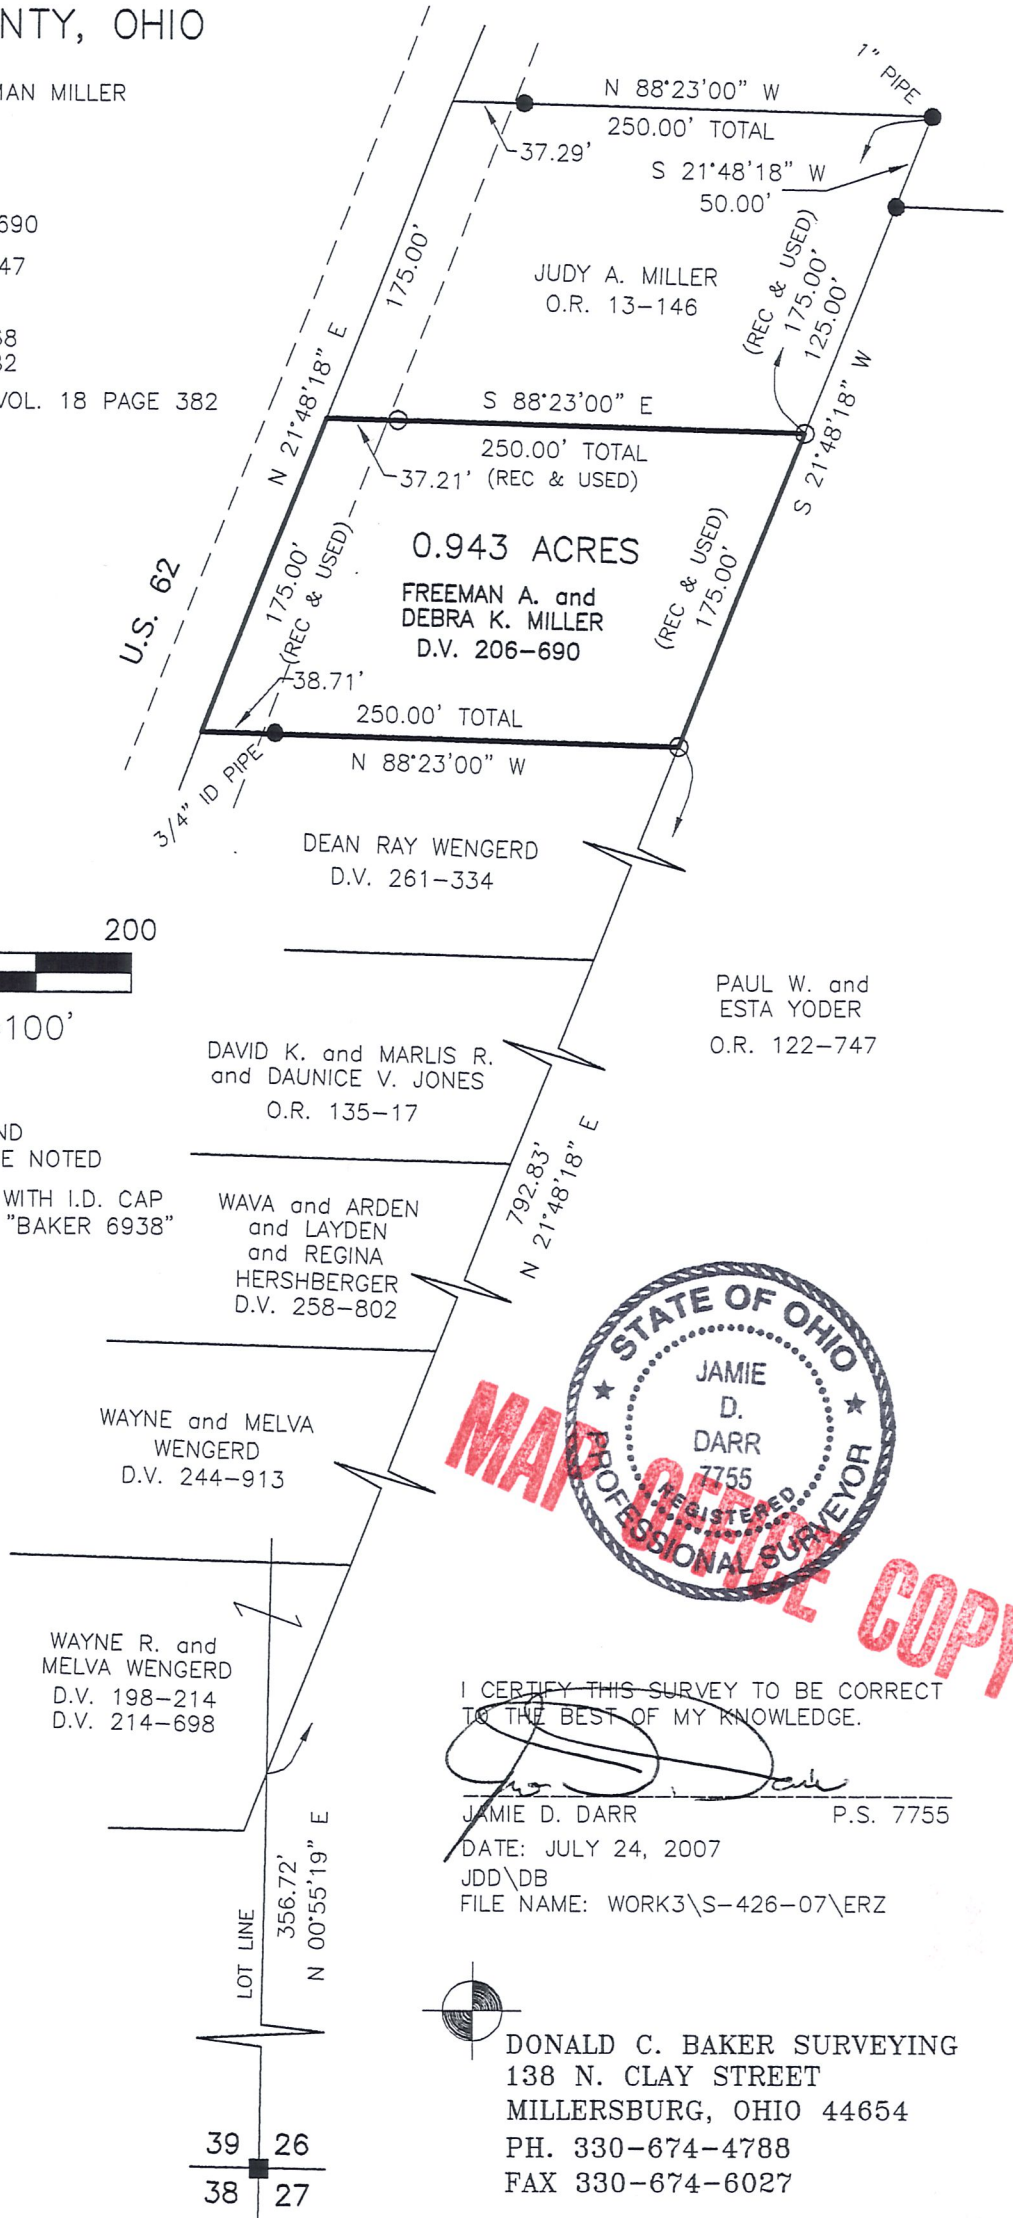


I CERTIFY THIS SURVEY TO BE CORRECT TO THE BEST OF MY KNOWLEDGE.

*Jamie D. Darr*  
 \_\_\_\_\_  
 JAMIE D. DARR P.S. 7755  
 DATE: JULY 24, 2007  
 JDD\DB  
 FILE NAME: WORK3\S-426-07\ERZ



DONALD C. BAKER SURVEYING  
 138 N. CLAY STREET  
 MILLERSBURG, OHIO 44654  
 PH. 330-674-4788  
 FAX 330-674-6027

39	26
38	27