



PAINT TOWNSHIP
 3RD. QTR., LOTS 28 & 29
 T-10 N; R-4 W
 HOLMES COUNTY, OHIO

SURVEYED FOR: DAVID YODER

REFERENCES

O.R. VOL. 11 PAGE 908
 O.R. VOL. 94 PAGE 508
 PLAT VOL. 2 PAGE 339
 BEARINGS FROM PLAT VOL 2 PAGE 339

RECEIVED
 AUG 26 2004
 Hol. Co. Tax Map Office

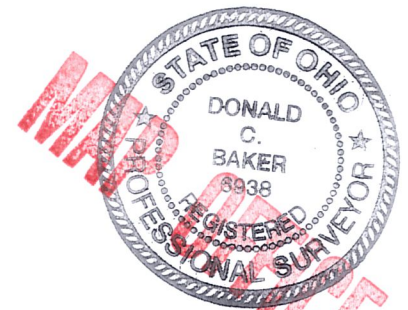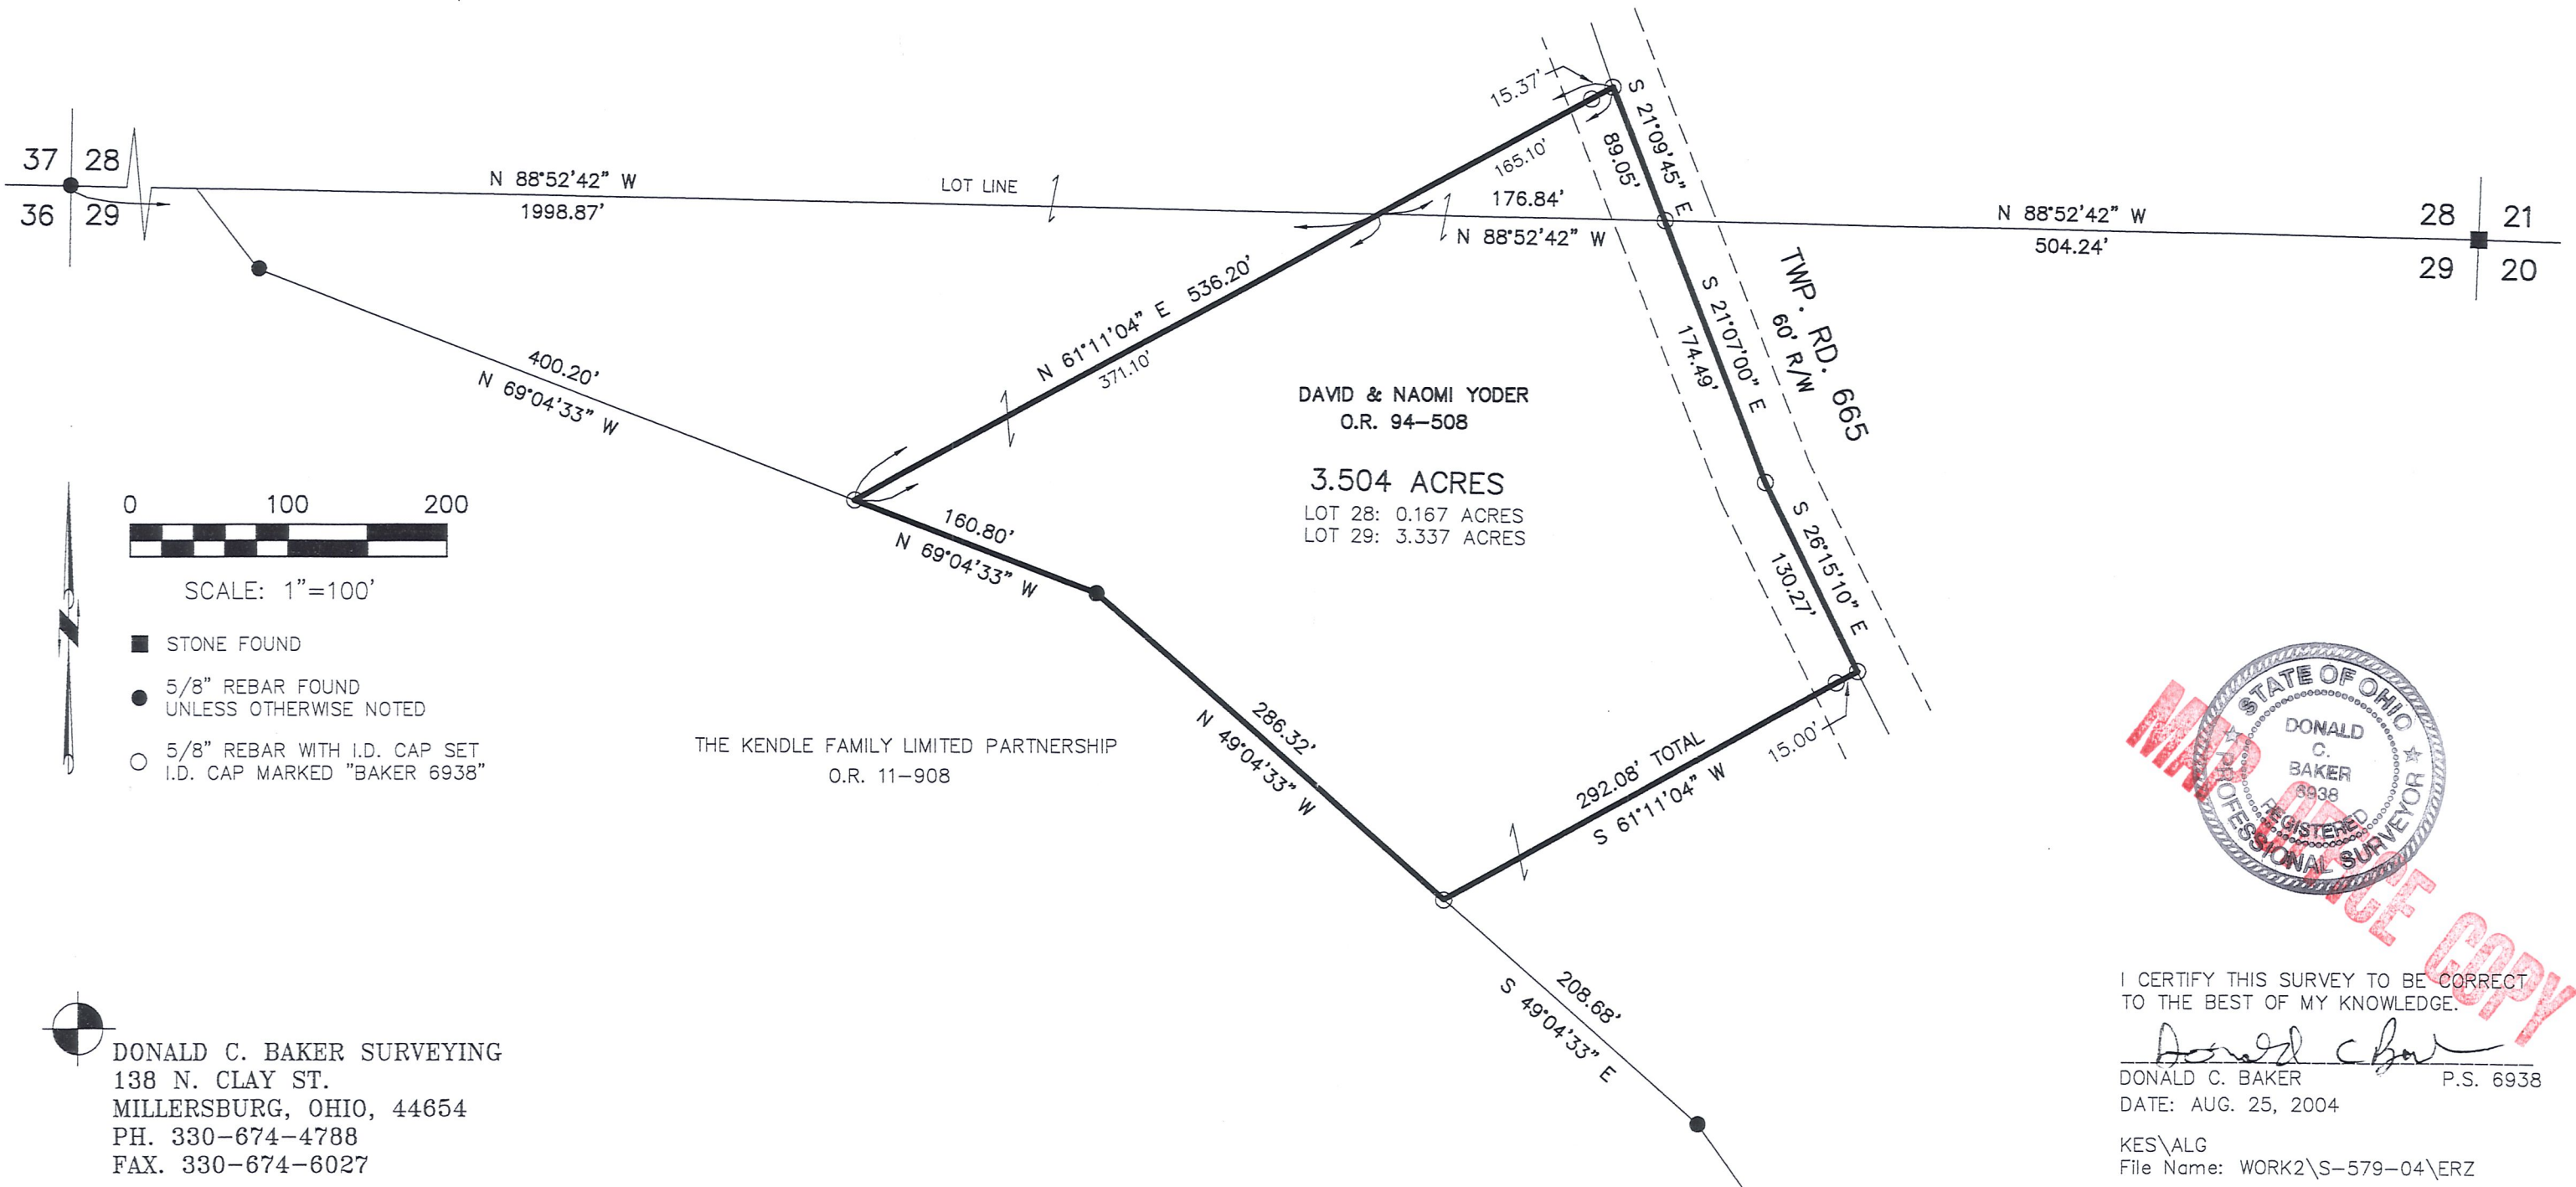

I CERTIFY THIS SURVEY TO BE CORRECT TO THE BEST OF MY KNOWLEDGE.

Donald C. Baker
 DONALD C. BAKER P.S. 6938
 DATE: AUG. 25, 2004

KES\ALG
 File Name: WORK2\S-579-04\ERZ

DONALD C. BAKER SURVEYING
 138 N. CLAY ST.
 MILLERSBURG, OHIO, 44654
 PH. 330-674-4788
 FAX. 330-674-6027