



REFERENCES:  
 DEED VOL. 278 PAGE 649  
 " " 274 " 327

SURVEY FOR PAROCHIAL SCHOOL LEASE

PAINT TOWNSHIP  
 3RD. QTR. LOT 33  
 T-10N; R-4W  
 HOLMES COUNTY, OHIO  
 (SURVEYED FOR: ROBERT L. TRIDER)



SCALE: 1" = 100'  
 ■ STONE FOUND  
 ● IRON PIN FOUND

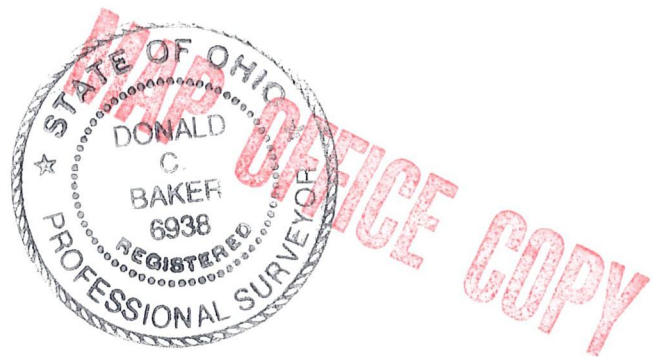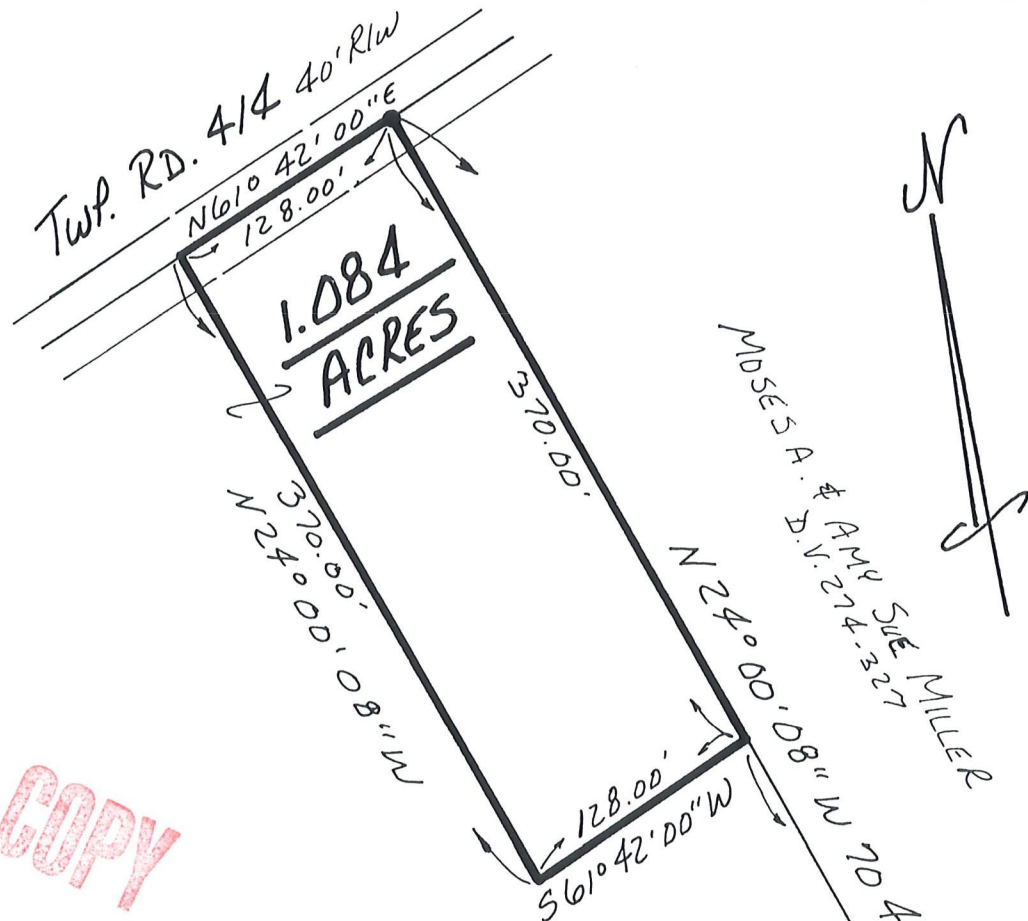

RECEIVED  
 MAY 03 1999  
 Hol. Co. Tax Map Office

I CERTIFY THIS SURVEY TO BE CORRECT  
 TO THE BEST OF MY KNOWLEDGE.

*Donald C. Baker*

DONALD C. BAKER P.S. 6938  
 138 N. CLAY ST.  
 MILLERSBURG, OHIO 44654  
 PH. (330) 674-4788  
 APRIL 30, 1999  
 #26799 - M.L. DAVIS  
 F.C.C. - D.C. BAKER

CHRISTENA M. YODER  
 D.V. 278-649

