

Walnut St. 35' N 21° 30' W

N 68° 30' E

29.5' 49.5' 49.5'

Lot 55


Lot 54

Lot 53

Teddy T. & Mary E. Chawning
Vol. 177 Pg. 310

Approximate area of encroachment

Approximate area of encroachment

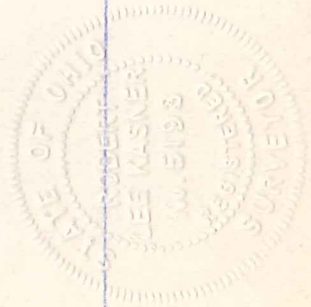


49.5' 49.5' 49.5'

Stark St. 60'

Note: Lot 54 & 53 (W 1/2) of 2nd Addition to the town of Winasburg dated August 17, 1843, located in Lot 38, 3rd 1/4, T 10 N, R 4 W of Point Twp, Hol. Co. Ohio.

Garage belonging to the party owning Lot 55 and the 8' x 25' portion of Lot 54 encroaches on Lot 54 owned by Chawning.

Garage belonging to Chawning was found to be encroaching on Lot 55.

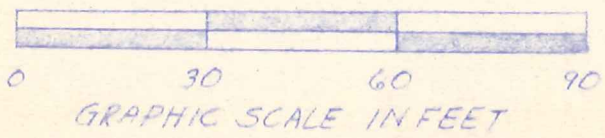

Robert L. Kasner
P.S. 5193, P.E. 28820
10/16/98

MAP OFFICE COPY