



VILLAGE OF WINESBURG  
 LOT 62  
 HOLMES COUNTY, OHIO

PAINT TOWNSHIP  
 T-10N R-4W  
 3RD QTR. LOT 38

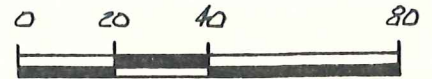

SCALE: 1" = 40'

- IRON PIN FOUND
- 5/8" REBAR WITH I.D. CAP SET  
I.D. CAP MARKED "BAKER 6938"

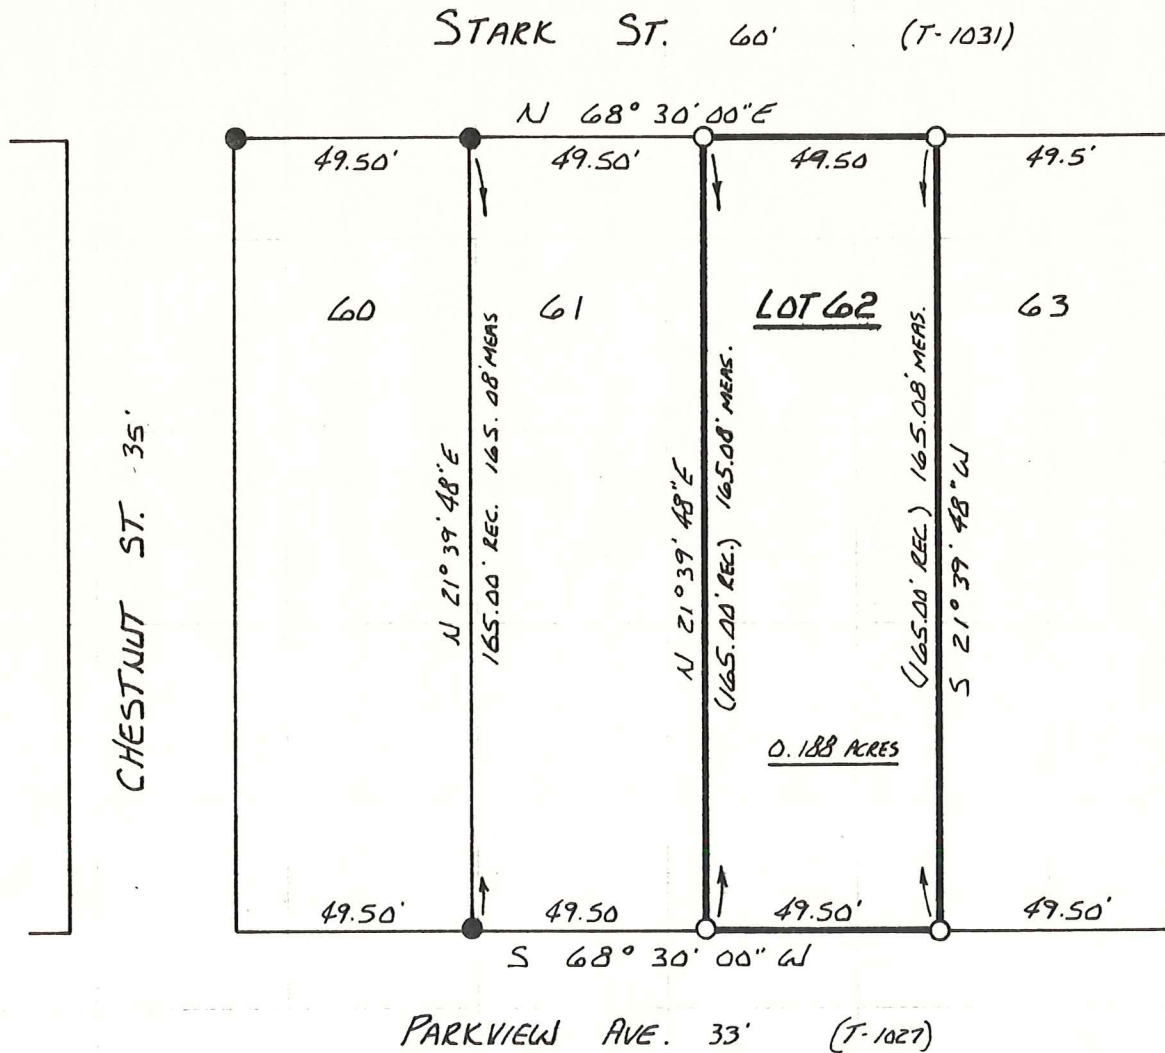

MAP



I CERTIFY THIS SURVEY TO BE CORRECT  
 TO THE BEST OF MY KNOWLEDGE.

*Donald C. Baker*

DONALD C. BAKER P.S. 6938  
 4321 T.R. 252  
 GLENMONT OH.

APRIL 27, 1989

COPY