


VILLAGE OF WINESBURG
PART OF D.L. 6 & D.L. 7

PAINT TOWNSHIP 3RD. QTR.
PART OF LOT 38, T-10N; R-4W
HOLMES COUNTY, OHIO

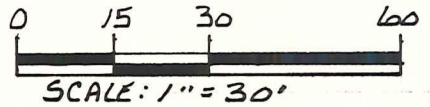


- ▲ R.R. SPIKE FOUND
- IRON PIN FOUND
- 5/8" RE BAR WITH I.D. CAP SET
I.D. CAP MARKED "BAKER 6938"


REFERENCES:

- PLAT VOL. 10 PAGE 834
- PLAT VOL. 10 PAGE 833
- PLAT VOL. 8 PAGE 452
- PLAT VOL. 8 PAGE 53
- DEED VOL. 231 PAGE 94
- DEED VOL. 236 PAGE 742

BEARINGS FROM DEED VOL. 236
PAGE 740

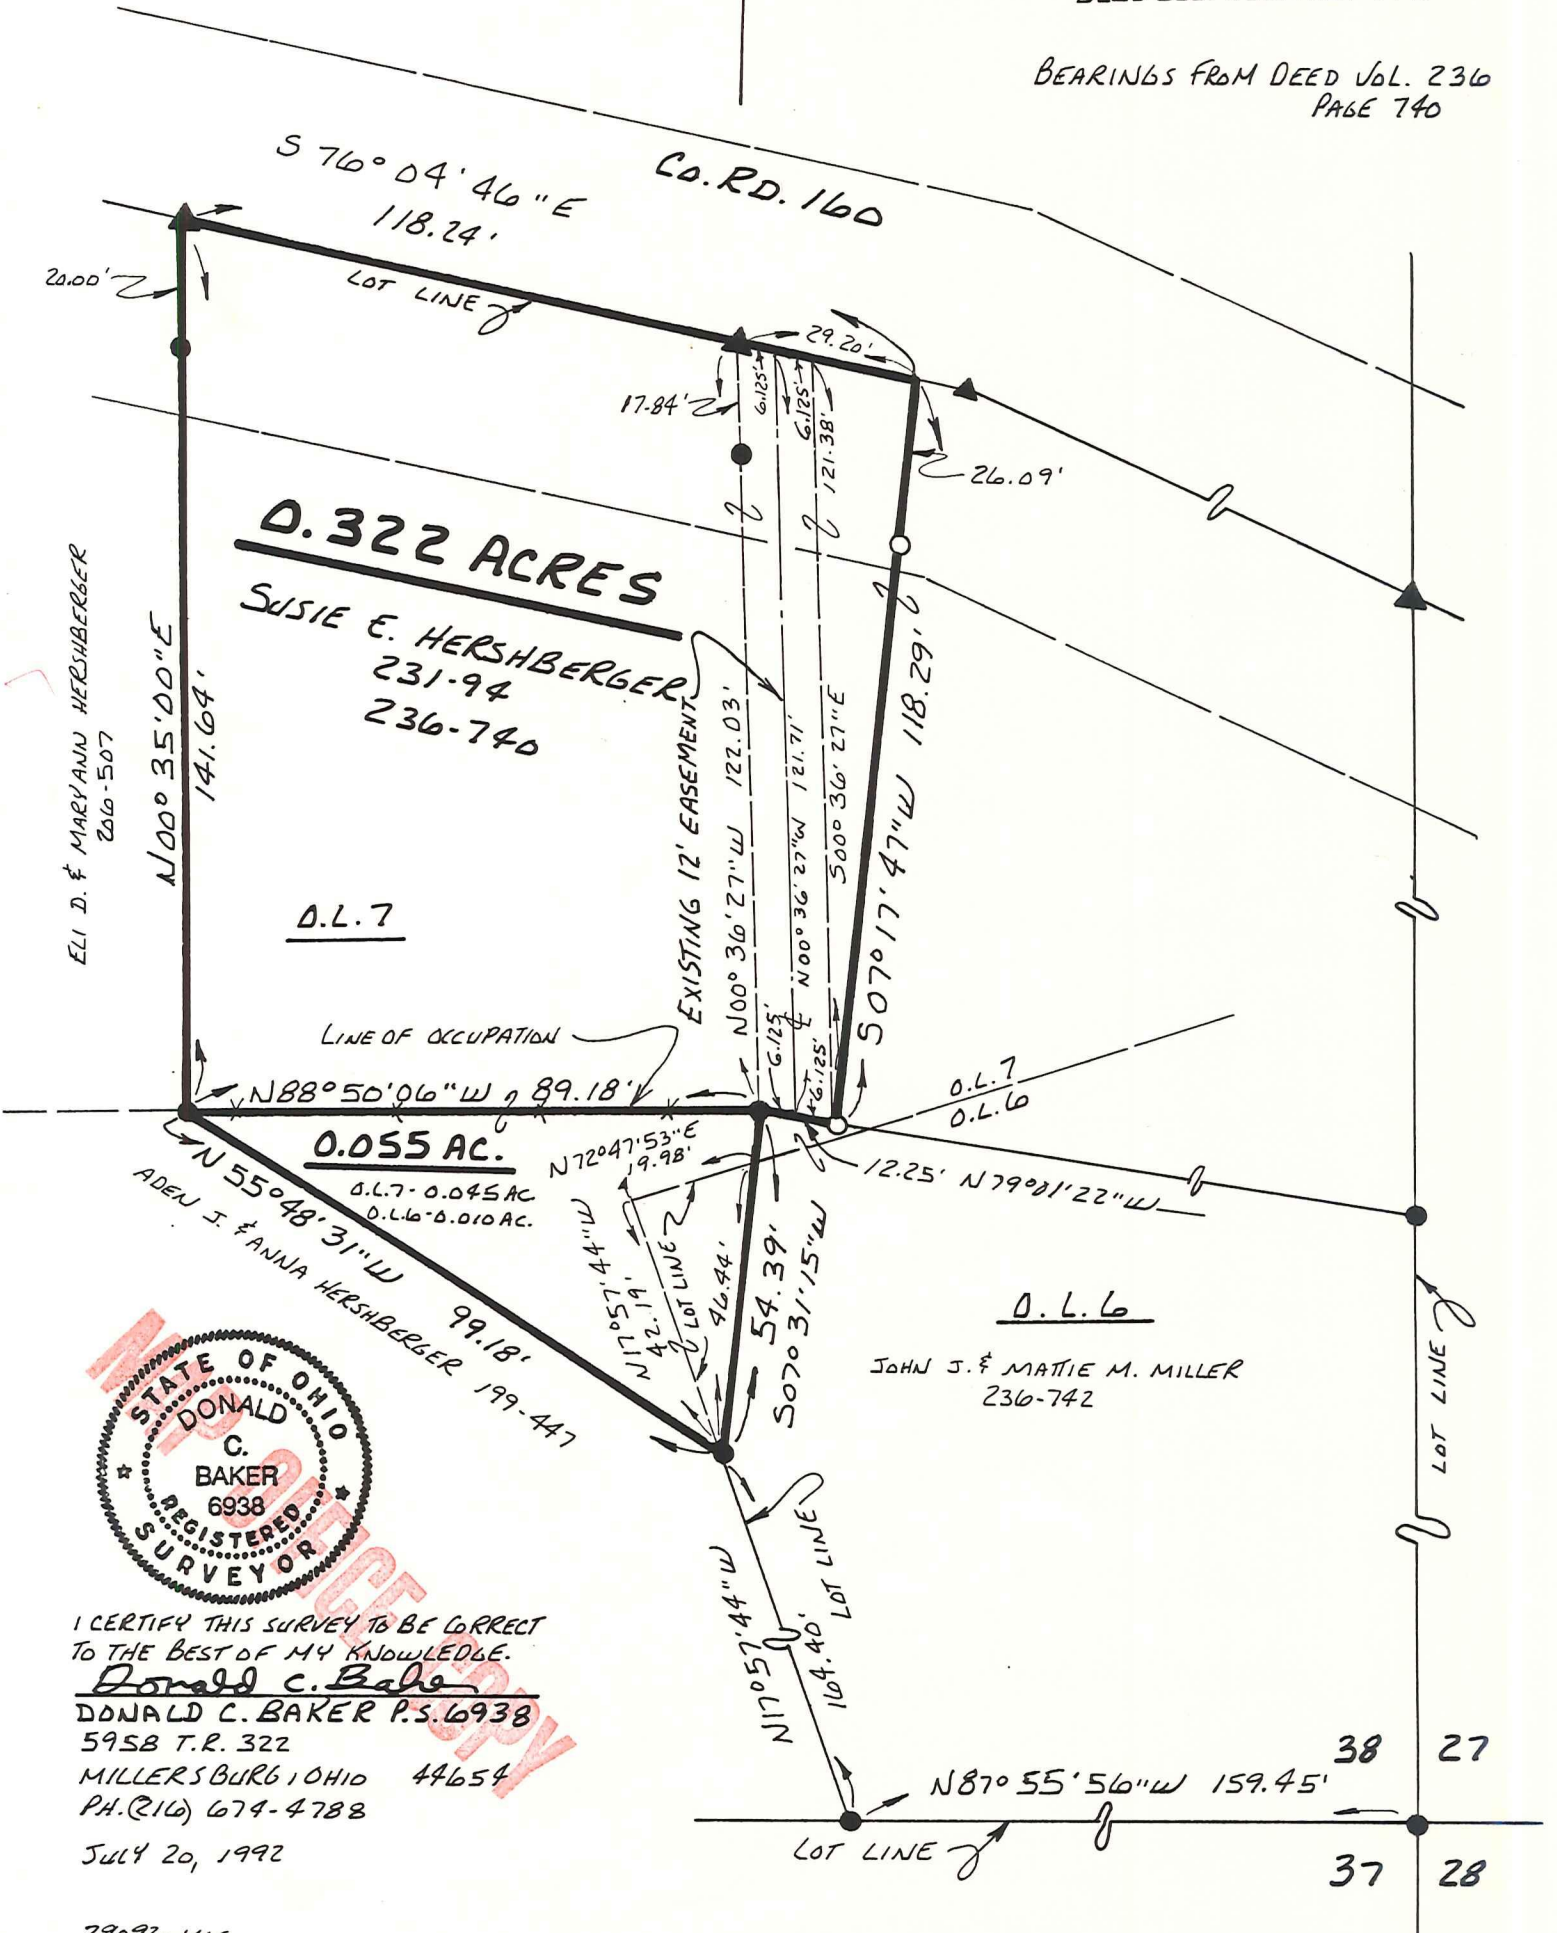

ELI D. & MARYANN HERSHBERGER
206-507

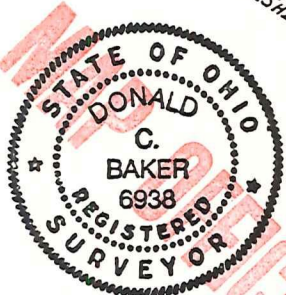

I CERTIFY THIS SURVEY TO BE CORRECT
TO THE BEST OF MY KNOWLEDGE.
Donald C. Baker
DONALD C. BAKER P.S. 6938
595B T.R. 322
MILLERSBURG OHIO 44654
PH. (716) 674-4788
JULY 20, 1992