



VILLAGE OF WINESBURG
PART OF OUT LOT 24

PAINT TWP. 3RD. QTR.
LOT 38, T-10N R-4W
HOLMES COUNTY, OHIO

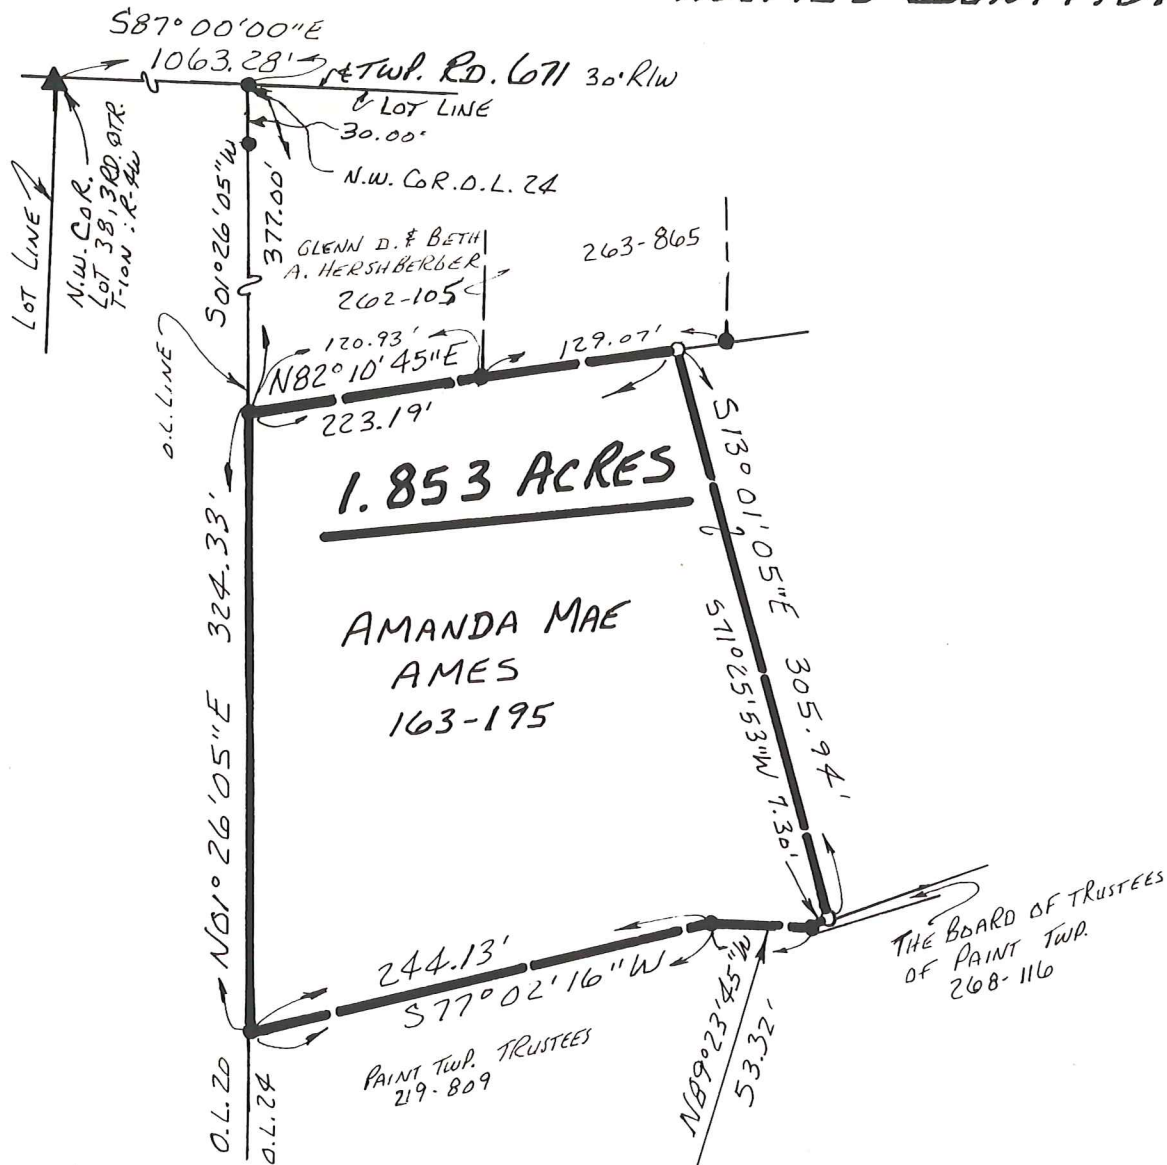

0 50 100 200

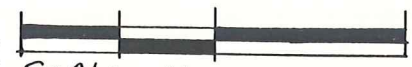

SCALE: 1" = 100'

- ▲ R.R. SPIKE FOUND
- IRON PIN FOUND
- 5/8" RE BAR WITH I.D. CAP SET I.D. CAP MARKED "BAKER 6938"

REFERENCES:

DEED VOL. 163 PAGE 195
 " " 262 " 105
 " " 263 " 865
 " " 262 " 103

PLAT VOL. 14 PAGE 342
 " " 5 " 130

BEARINGS FROM SURVEY
 RECORD 3 PAGE 187

MAP



I CERTIFY THIS SURVEY TO BE CORRECT TO THE BEST OF MY KNOWLEDGE.

Donald C. Baker

DONALD C. BAKER P.S. 6938

5958 T.R. 322

MILLERSBURG, OHIO

44654

PH. (216) 474-4788

OCTOBER 27, 1995

58895-MLS