


VILLAGE OF WINESBURD  
LOTS 36, 37 & PART OF LOT 38

REFERENCES:  
D.V. 249-446  
O.R. 20-678  
O.R. 21-979

PAINT TOWNSHIP  
3RD. QTR. LOT 38  
T-10 N; R-4 W  
HOLMES COUNTY, OHIO  
(SURVEYED FOR: MIKE HERNDON)

BEARINGS FROM S.R. 5 Pg. 316

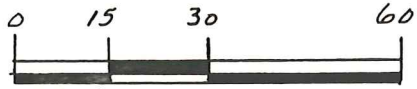

SCALE: 1" = 30'


- 5/8" RE BAR WITH I.D. CAP SET  
I.D. CAP MARKED "BAKER 6938"



I CERTIFY THIS SURVEY TO BE CORRECT  
TO THE BEST OF MY KNOWLEDGE.

Donald C. Baker  
DONALD C. BAKER P. S. 6938  
138 N. CLAY ST.  
MILLERSBURG, OHIO 44654  
PH. (330) 674-4788  
FEBRUARY 25, 1999  
# 3799 - M.L. DAVIS  
F.C.C. - F.D. BAKER

33' ALLEY AKA PARKVIEW AVE.

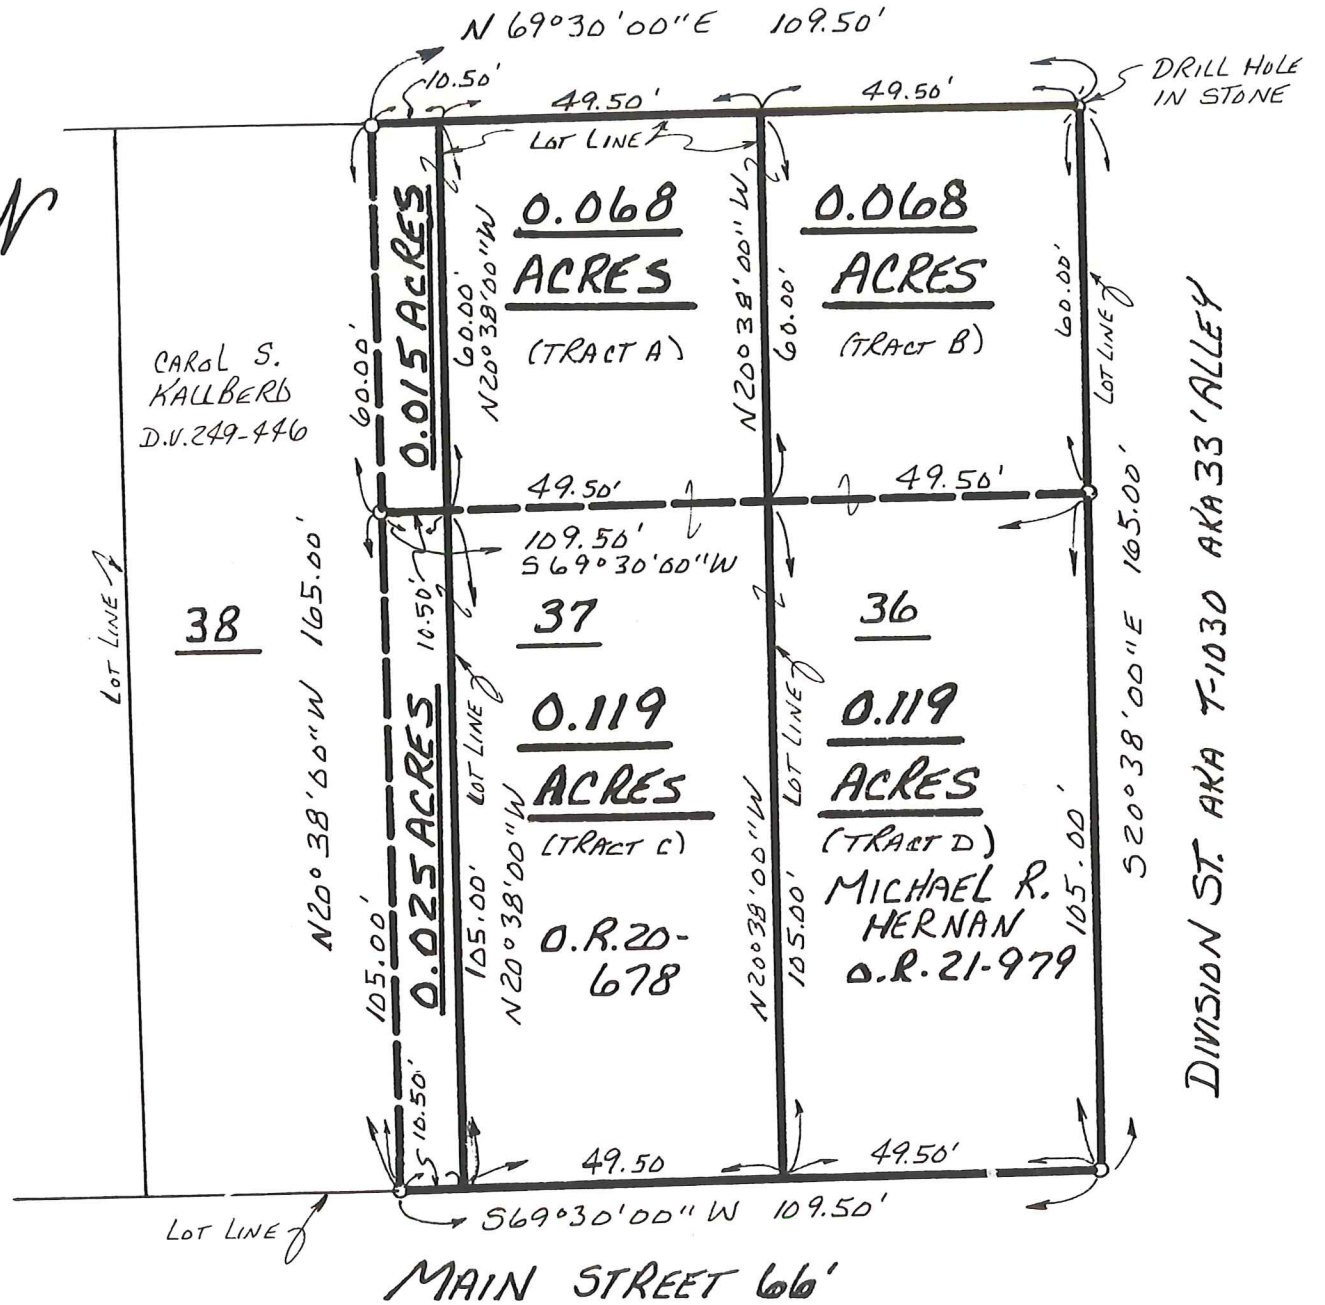

DIVISION ST. AKA T-1030 AKA 33' ALLEY