

VILLAGE OF WINESBURG  
LOTS 56, 57, 58 & 59

PAINT TOWNSHIP  
3RD. QTR., LOT 38  
T-10 N; R-4 W  
HOLMES COUNTY, OHIO



SURVEYED FOR: TIM HERSHBERGER

REFERENCES

DEED VOL. 182 PAGE 977

PLAT VOL. 19 PAGES 197 & 290

BEARINGS FROM PLAT VOL. 19 PAGE 290

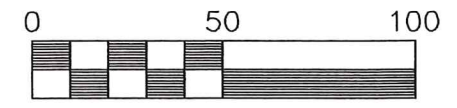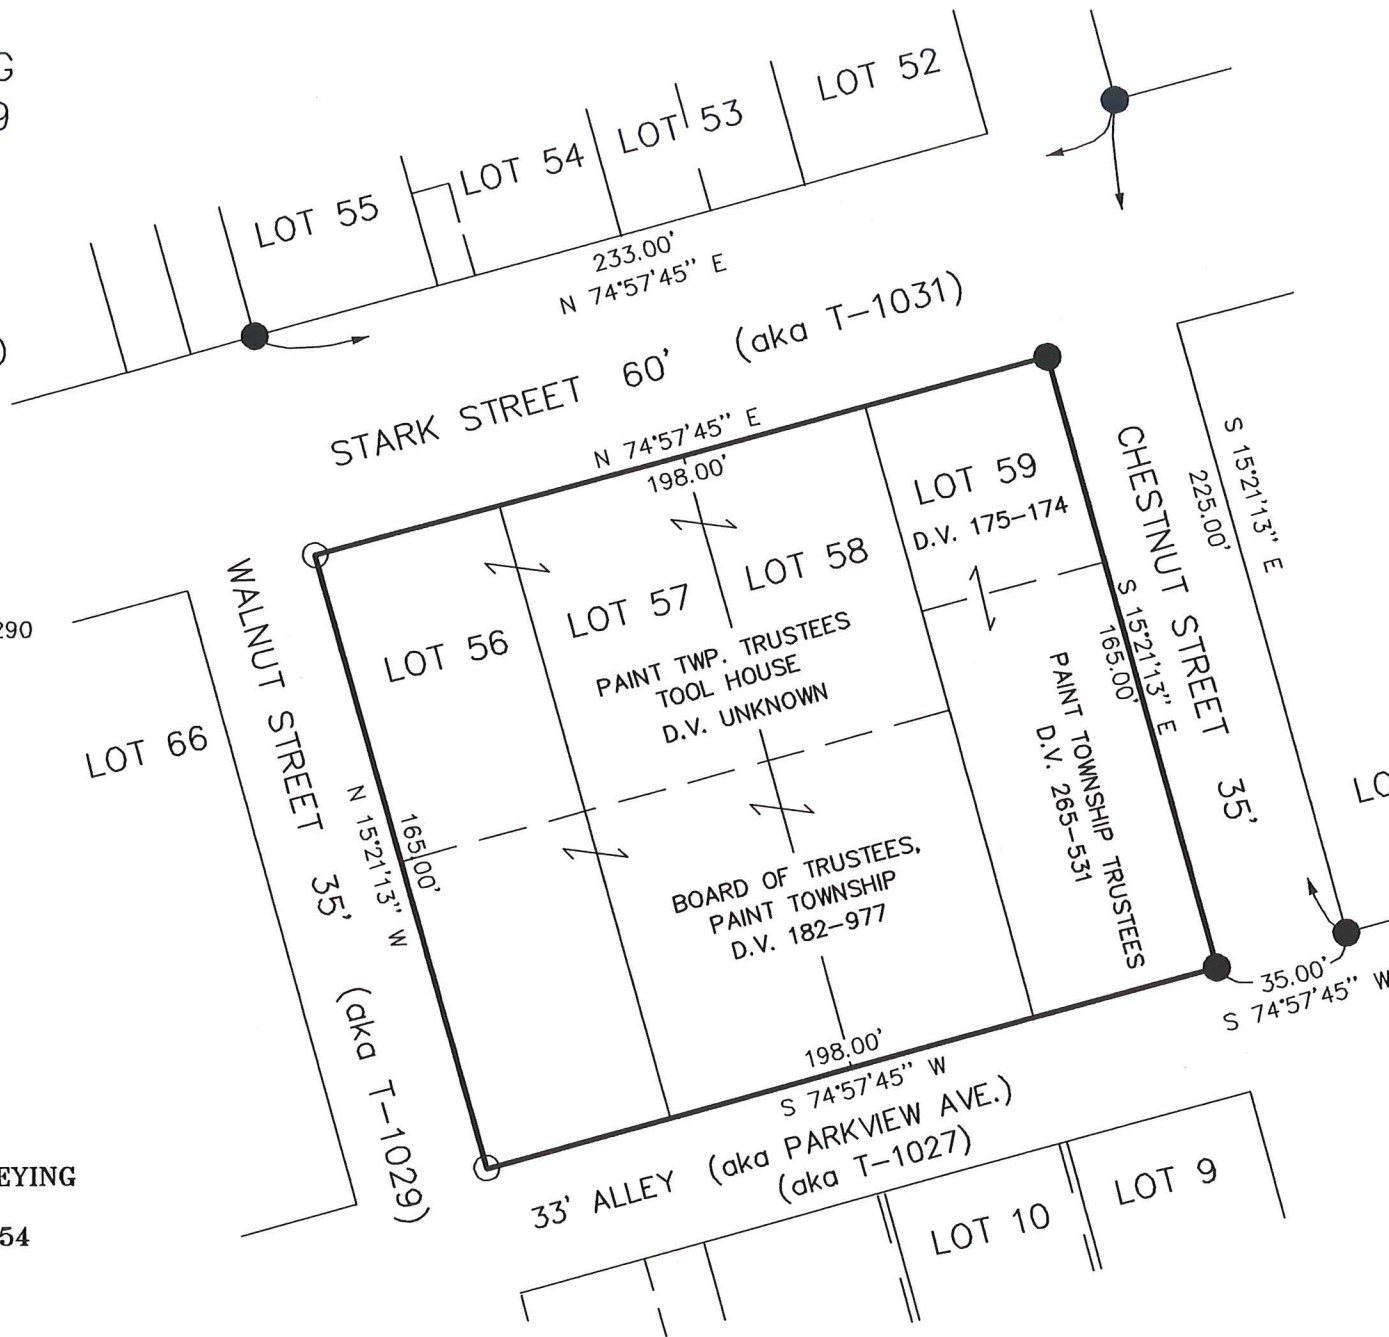

Scale 1" = 50'

- 5/8" REBAR FOUND
- 5/8" REBAR WITH ID CAP SET ID CAP MARKED "BAKER 6938"



COPY

I CERTIFY THIS SURVEY TO BE CORRECT TO THE BEST OF MY KNOWLEDGE.

*Jamie D. Darr*  
JAMIE D. DARR P.S. 7755

DATE: JUNE 17, 2005

JDD\ALG  
File Name: C:\JOBS1\S-269-05\ERZ



DONALD C. BAKER SURVEYING  
138 N. CLAY ST.  
MILLERSBURG, OHIO 44654  
PH. 330-674-4788  
FAX. 330-674-6027